Name Harry L. Hansen **Service No.** 112

Address 41 Woodland Road

Lot #31 **Location** Lot 31

Kind of Pipe **Size** **Size of Main**

Repair—Renewal—New Service Eagle #1482 **Location** DEC 22 1969

Date		Material	Amount	Total	Date		Amount
9-1-69	42'	6" Transite pipe @9.00		378.00	10-16-69	Deposit	378.00
10-10-69	90'	6" Transite pipe					
	13'	4" Cast Iron pipe					

R.B.K.18501

DATE _____

TOWN OF LEXINGTON — BOARD OF PUBLIC WORKS

SEWER DIVISION

Sketch of Service Here

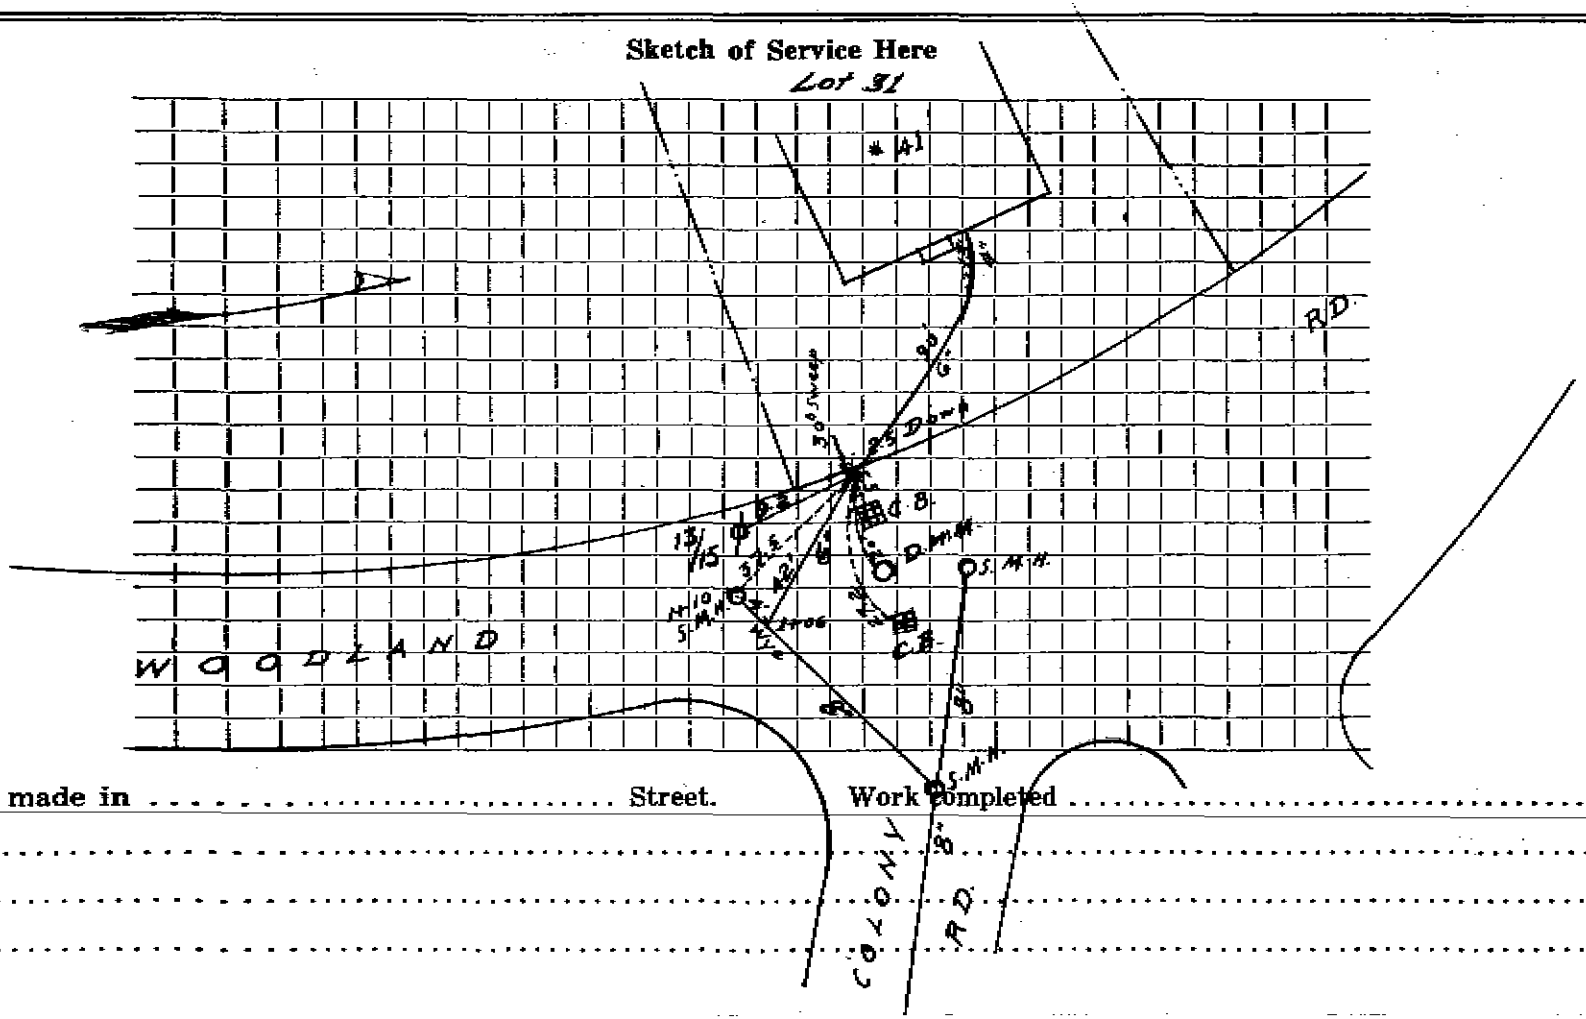

Connection made in ..... Street. Work completed .....

Remarks: .....

.....

.....