Name Louis Ciampa **Service No.** 80

Address 136 Worthen Road Lot 44

Location

Kind of Pipe **Size** **Size of Main**

~~[illegible]~~ New Service DeFlice Bros. Permit#338 **Location** AUG 9 1965

Date		Material	Amount		Total		Date		Amount	
8-22-60		Labor	13	08			6-17-65	Deposit	44	04
		10% O.H.	1	31	14	39				
	30'	6" Transite pipe			21	00				
	1	Hr. Trucking @3.00			3	00				
		6 x 8 Saddle			5	65				
		Bill When Connected			44	04				
7-12-65	50'	6" Transite pipe								

DATE _____

TOWN OF LEXINGTON — BOARD OF PUBLIC WORKS

SEWER DIVISION

Sketch of Service Here

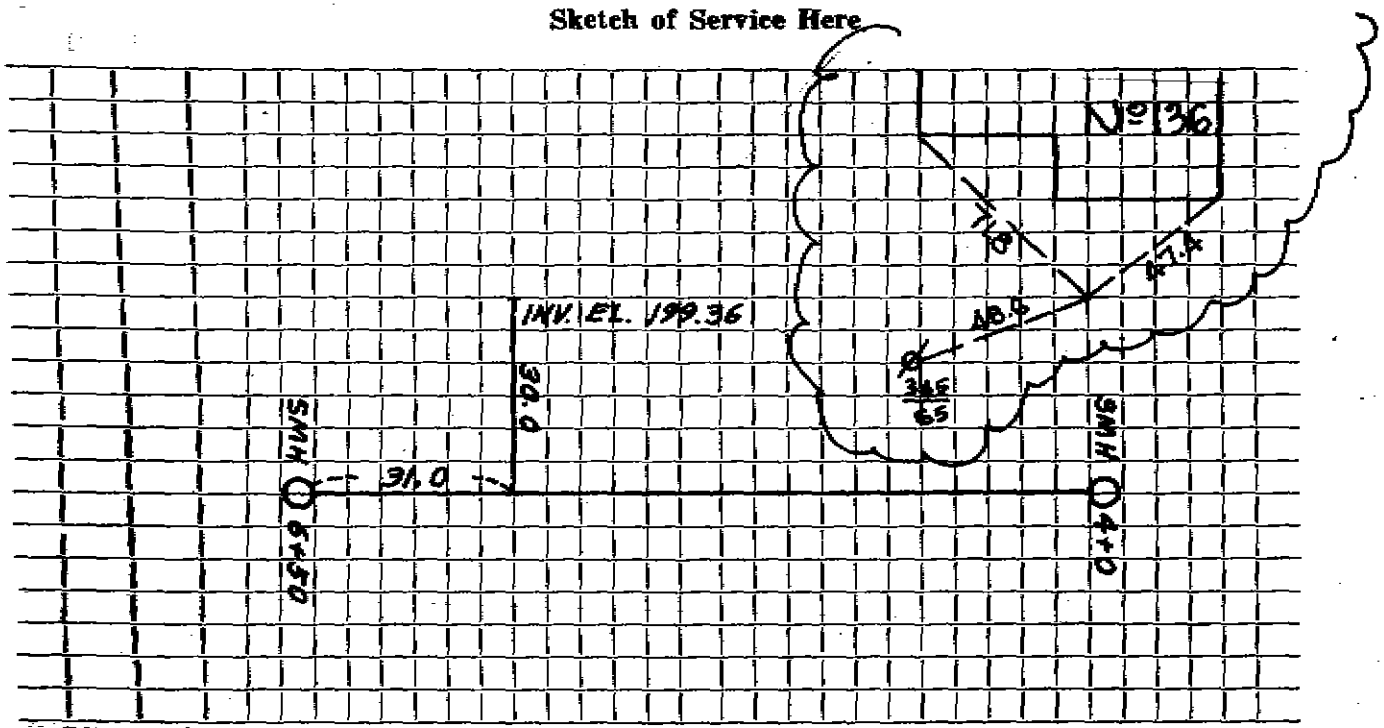

Connection made in ..... Street. Work completed .....

Remarks: .....

.....

.....