Name Duffy Bros. **Service No.**

Address 231 Worthen Road

Lot #182 **Location**

Kind of Pipe **Size** **Size of Main**

Repair—Renewal—New Service Bonanno #587 #1244 **Location**

Date		Material	Amount	Total	Date		Amount
7-6-67	55'	6" Transite pipe					
10/31/68	10'	4" Cast Iron					
	37'	6" Transite Pipe					

H.S.M.18501

DATE_____

TOWN OF LEXINGTON — BOARD OF PUBLIC WORKS

SEWER DIVISION

Sketch of Service Here

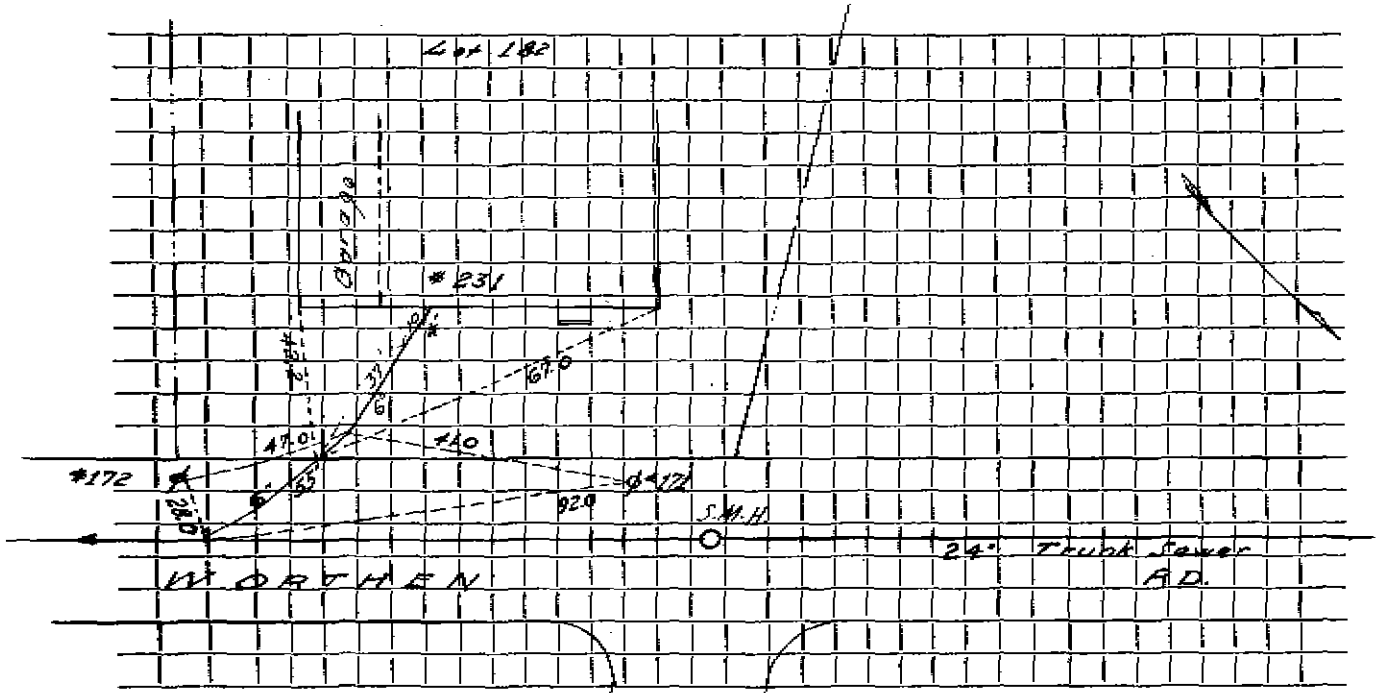

Connection made in ..... Street, Work completed .....

Remarks: .....

.....

.....