Name Duffy Brothers **Service No.**

Address 234 Worthen Road

Location Lot #211

Kind of Pipe **Size** **Size of Main**

Repair—Renewal—New Service Bonanno - Permit # 590 #1034 **Location**

Date		Material	Amount	Total	Date		Amount
6/10/67	30'	6" Transite					
5/23/68	10'	4" Cast Iron					
	36'	6" Transite					

H.B.K.18501

DATE .....

TOWN OF LEXINGTON — BOARD OF PUBLIC WORKS

SEWER DIVISION

Sketch of Service Here

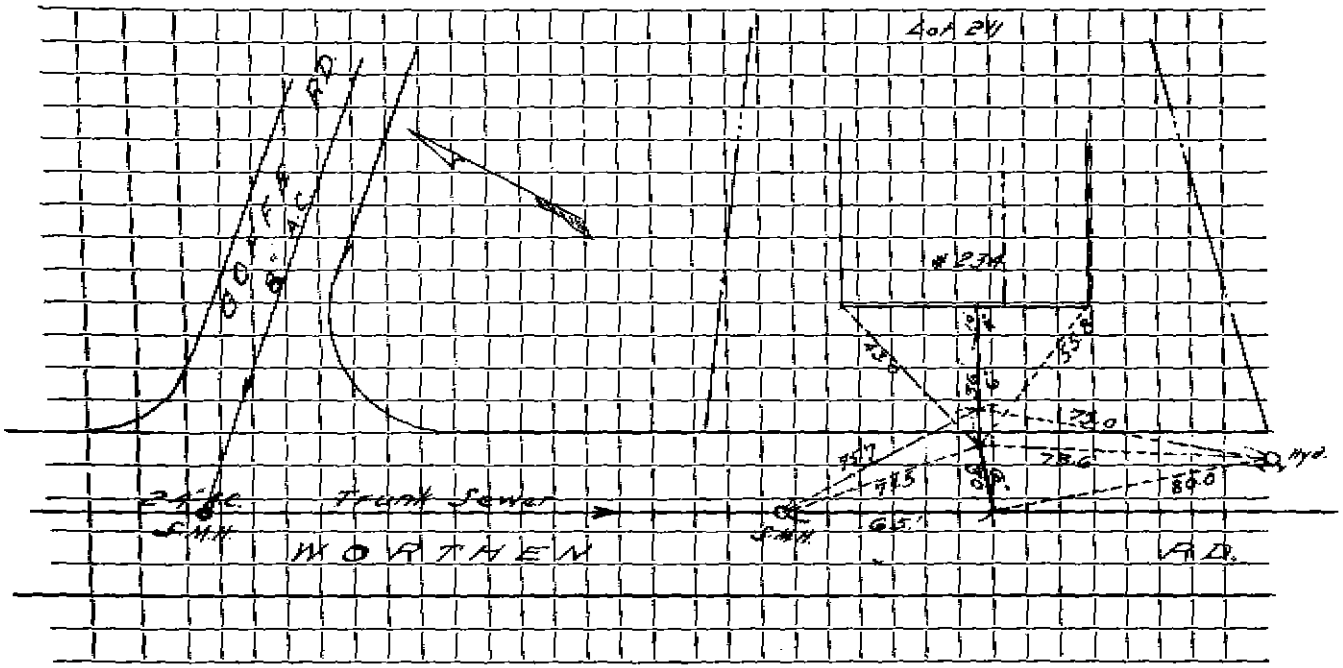

Connection made in ..... Street. Work completed .....

Remarks: .....

.....

.....