Name Duffy Brothers **Service No.**

Address 235 Worthen Road

Location Lot #180

Kind of Pipe **Size** **Size of Main**

Repair—Renewal—New Service Bonanno - Permit #591 #1036 **Location**

Date		Material	Amount		Total		Date			Amount	
6/10/67	42'	6" Transite									
5/23/68	10'	4" Cast Iron									
	34'	6" Transite									

H.B.K.16501

DATE _____

TOWN OF LEXINGTON — BOARD OF PUBLIC WORKS

SEWER DIVISION

Sketch of Service Here

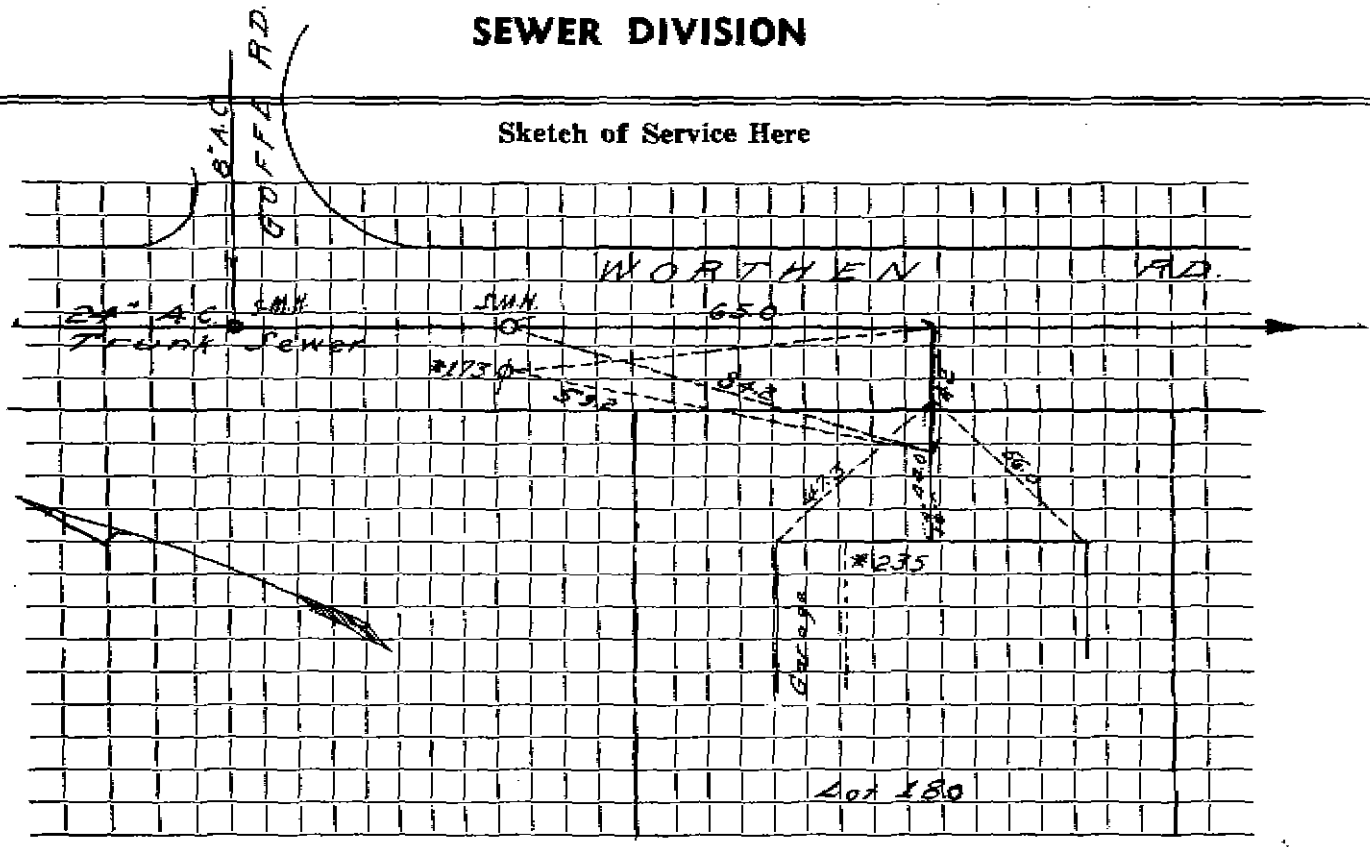

Connection made in ..... Street. Work completed .....

Remarks: .....

.....

.....