Name Duffy Bros. **Service No.**

Address 236 Worthen Road

Location Lot #210

Kind of Pipe **Size** **Size of Main**

Repair—Reawal—New Service Bonanno - Permit #592 & 707 **Location**

Date		Material	Amount	Total	Date		Amount
6/19/67	40.5	6" Transite					
7-21-67	19½'	6" Transite pipe					
	10'	4" Cast Iron pipe					

F.B.N.18501

DATE _____

TOWN OF LEXINGTON — BOARD OF PUBLIC WORKS

SEWER DIVISION

Sketch of Service Here

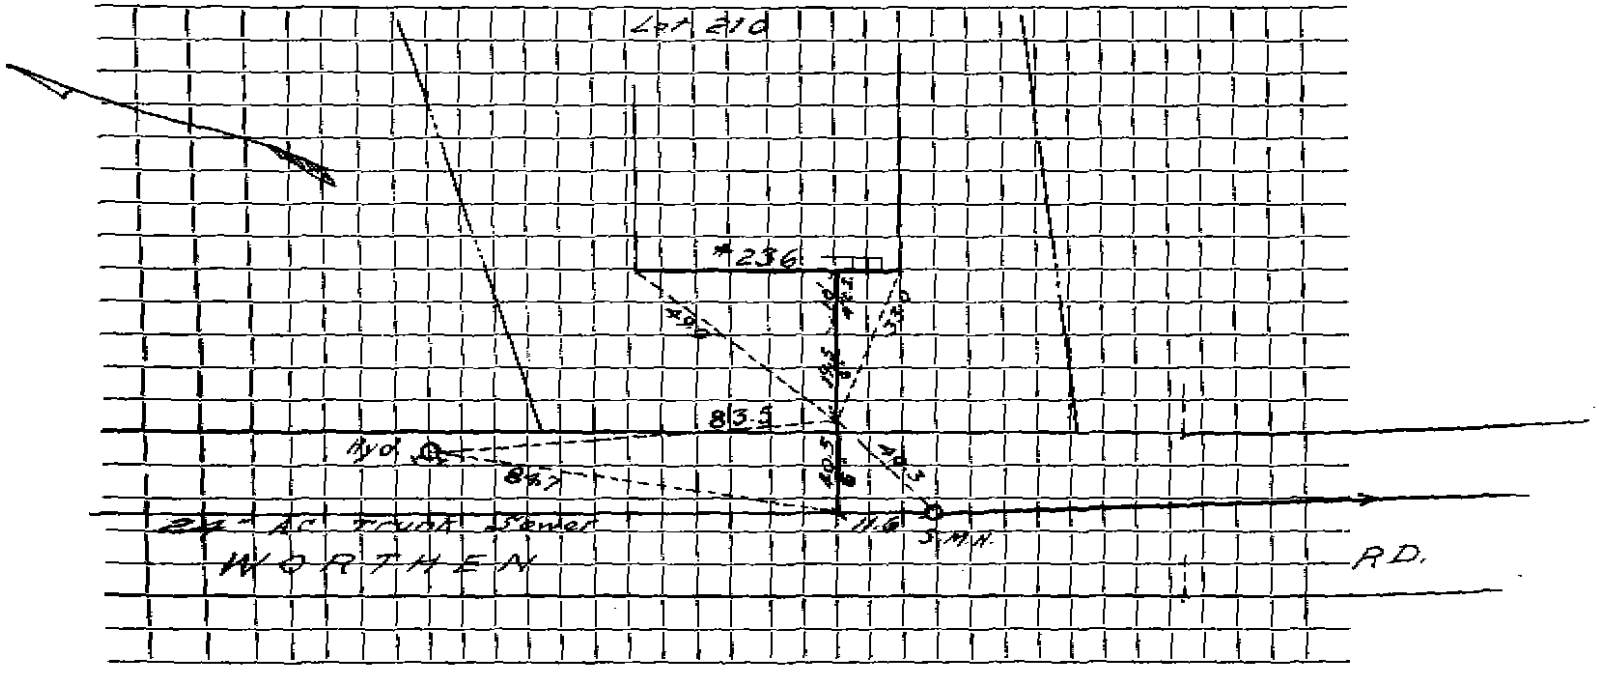

Connection made in . . . . . Street. Work completed . . . . . .

Remarks: . . . . . .

. . . . . .

. . . . . .