Name

Service No.

Address 14 Wyman Rd

Location

Kind of Pipe PVC Size 6" Size of Main 8"

Repair—Renewal—(New) Service Arlex Location LOT 276A

Date		Material	Amount	Total	Date		Amount
09/09	17.6	4" PVC					
	1	4x6 Fernco					
	2	Clean outs					
	99'	6" PVC					
	1	6x6 Fernco 6.6 DUNO PVCxAC					
9/9/94		Ex. T					
	20'	6"-A.C.					

DATE _____

TOWN OF LEXINGTON — BOARD OF PUBLIC WORKS

SEWER DIVISION

Sketch of Service Here

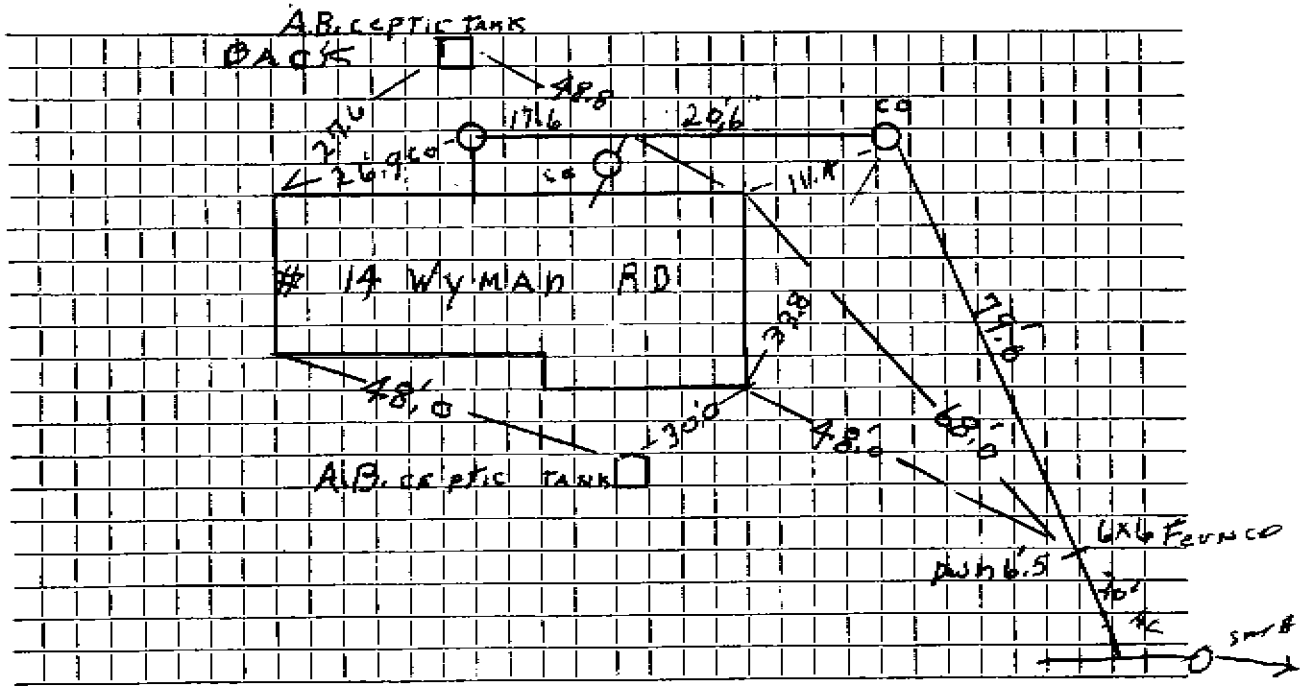

Connection made in ..... Street. Work completed 9/23/09 Arlex oil Corp.....

Remarks: Back Tank 750 GAL, Front 1000 GALS (ABANDON) .....

.....

.....