Name Ruth Karpinski

Service No. 93

Address #24 Wyman Road

Location

Kind of Pipe A.C. Size 6" Size of Main 8"

Repair—Renewal—New Service Valve # 2585 Location

OCT 25 1976

Date	Material	Amount	Total	Date		Amount
10/7/04	19.0 A.C.	$8.00	$152.00	11-22-04	Deposit	152.00

P.W.18-01

DATE _____

TOWN OF LEXINGTON — BOARD OF PUBLIC WORKS

SEWER DIVISION

Sketch of Service Here

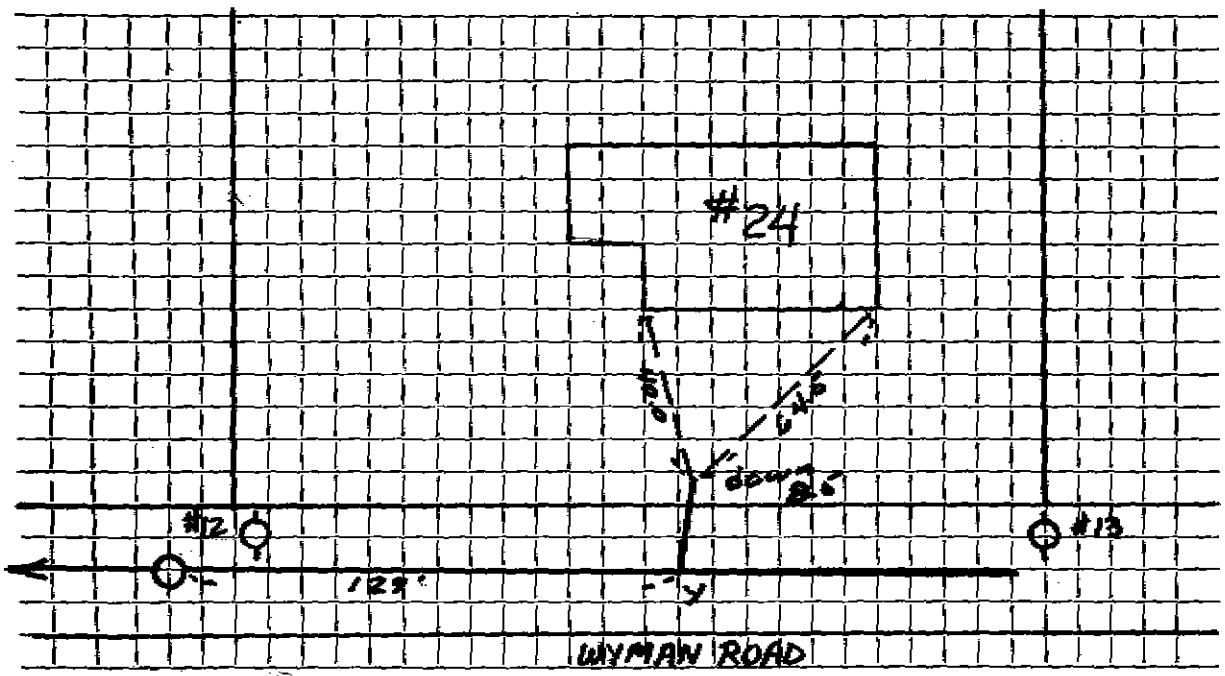

Connection made in ..... Street. Work completed .....

Remarks: .....

.....

.....