Name D. Sparrow

Service No. 90

Address #26 Wyman Road

Location

Kind of Pipe A.C.

Size 6"

Size of Main 8"

Repair—Renewal—New Service Valvi #2584

Location

OCT 25 1976

Date	Material	Amount	Total	Date		Amount
10/21/74	19.0 A.C	$8.00	$152.00	11-25-74	Deposit	152.00

S.N.18501

DATE.....

TOWN OF LEXINGTON — BOARD OF PUBLIC WORKS

SEWER DIVISION

Sketch of Service Here

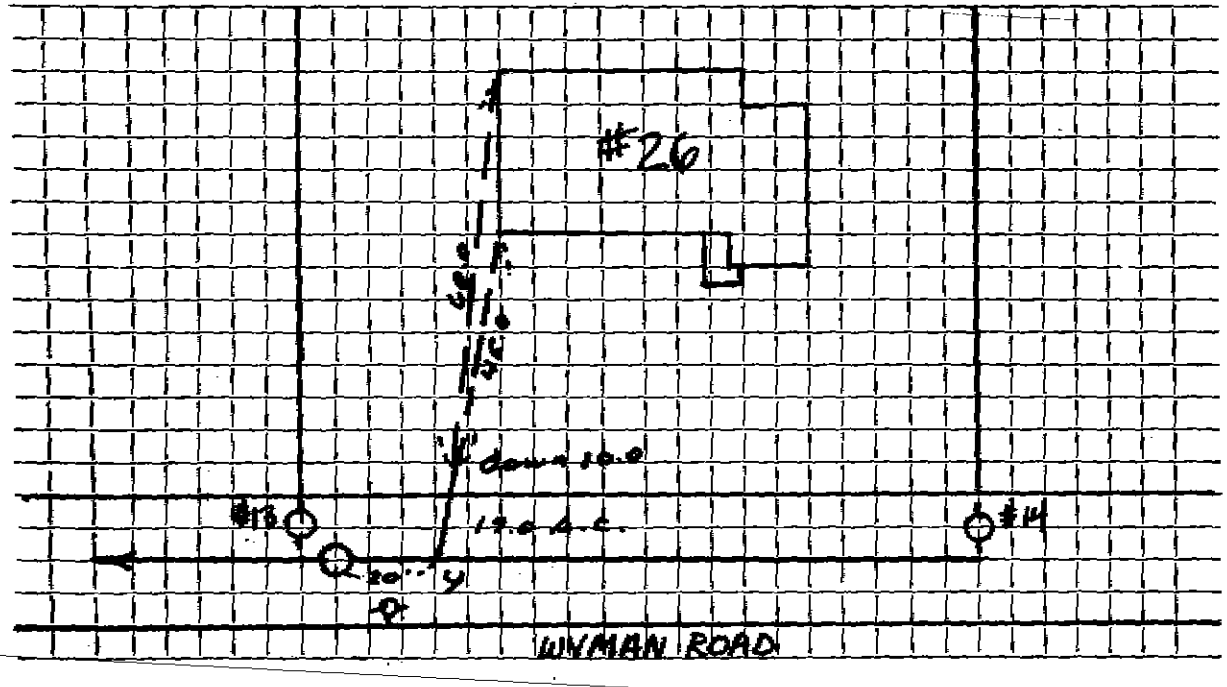

Connection made in ..... Street. Work completed .....

Remarks: .....

.....

.....