Name Todd Dillard

Service No. 91

Address #33 Wyman Road

Location

Kind of Pipe A.C.

Size 6"

Size of Main 8"

Repair—Renewal—New Service Valve #

Location

OCT 25 1976

Date	Material	Amount	Total	Date		Amount
10/7/74	25' A.C.	$ 8.00	$ 200.00	11-22-74	Deposit	200.00

E.B.K.18-01

DATE _____

TOWN OF LEXINGTON — BOARD OF PUBLIC WORKS

SEWER DIVISION

Sketch of Service Here

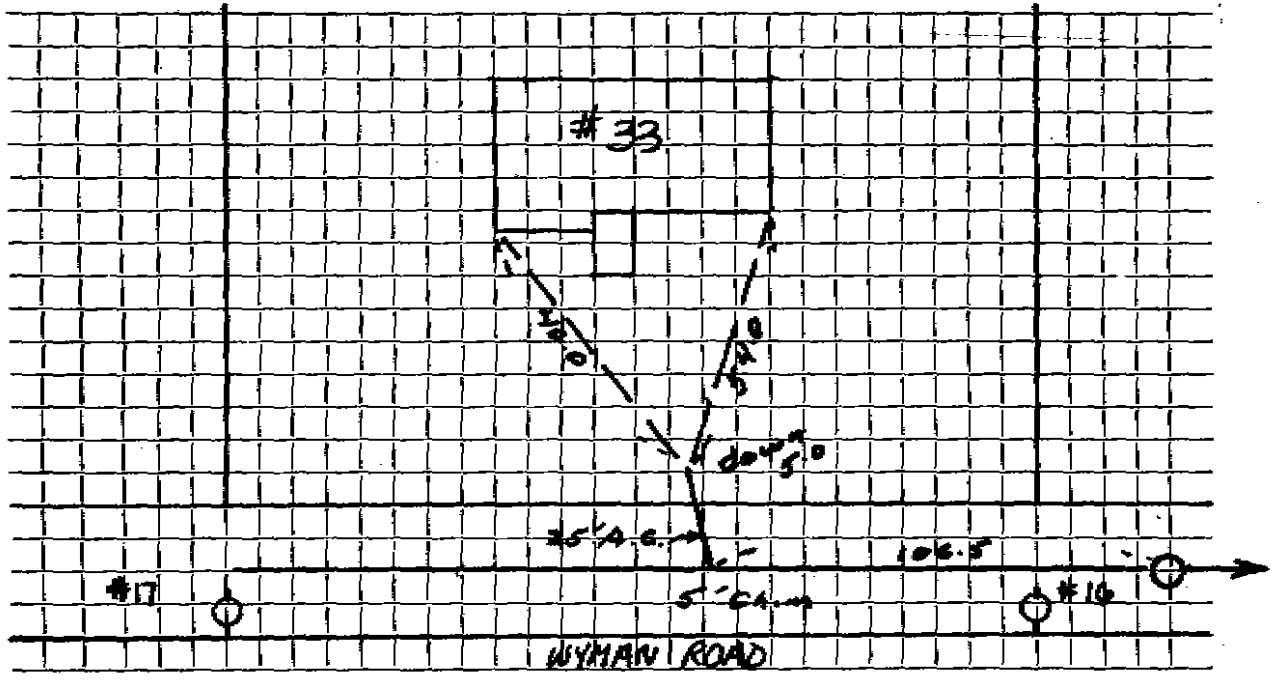

Connection made in ..... Street. Work completed .....

Remarks: .....

.....

.....