Name Gus Karlson **Service No.** 176

Address 12 YORK ST.

Location

Kind of Pipe A.C. **Size** 6" **Size of Main** 8"

Repair—Renewal—New Service Trabino Const. **Location** APR 8 1974

Date	Material	Amount	Total	Date		Amount
8/14/73	24'-6" A.C.P. @ $9.00	$ 216.00		11-14-73	Deposit	$16 00
12-3 73	30'-6" ACP					
	10'-4" CI					

F.B.M.18501

DATE _____

TOWN OF LEXINGTON — BOARD OF PUBLIC WORKS

SEWER DIVISION

Sketch of Service Here

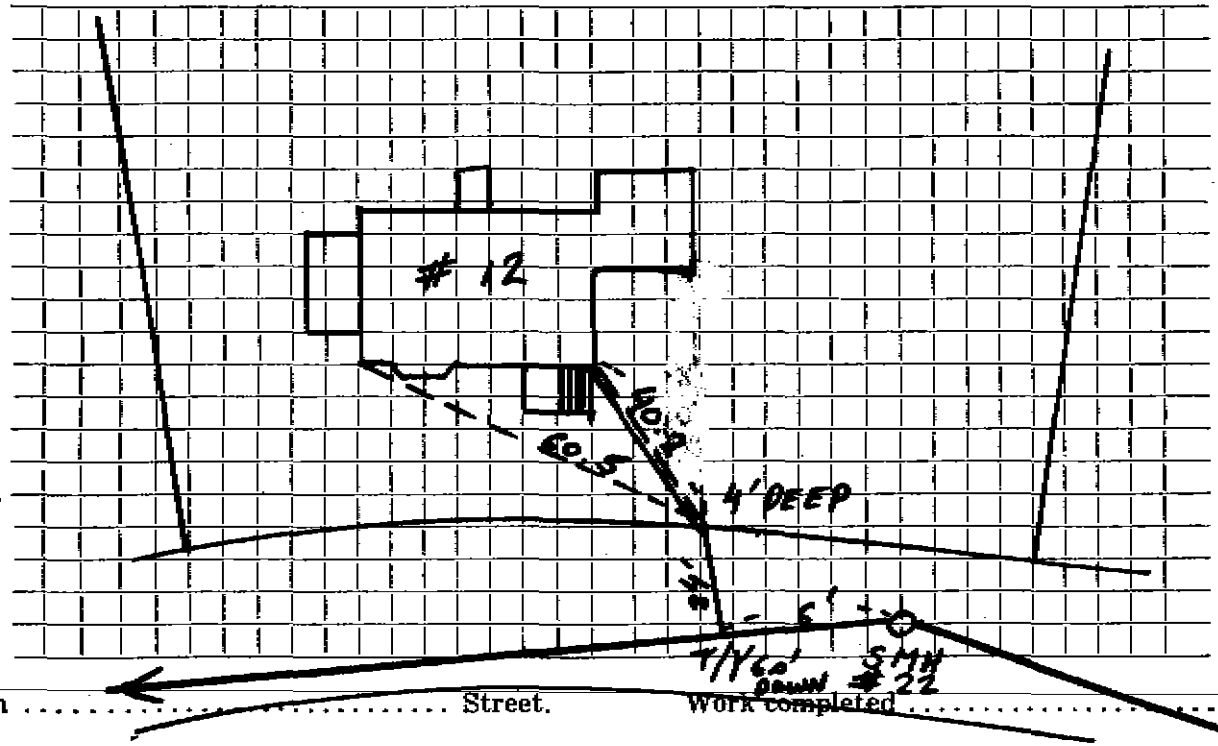

Connection made in ..... Street. Work completed .....

Remarks: .....

.....

.....