Name Leonard Rose **Service No.** 63

Address 59 York Street

Lot 34 **Location**

Kind of Pipe **Size** **Size of Main**

Repair—Renewal—New Service Lexington Sewerage Company #1903 **Location** JUN 5 1972

Date		Material	Amount	Total	Date		Amount
1969	19.5	6" Transite pipe @10.00 per ft.		195.00	9-1-71	Deposit	185.00
9-1-71	70'	6" Transite pipe					
	15'	4" Cast Iron					

F.B.N.18503

DATE _____

TOWN OF LEXINGTON — BOARD OF PUBLIC WORKS

SEWER DIVISION

Sketch of Service

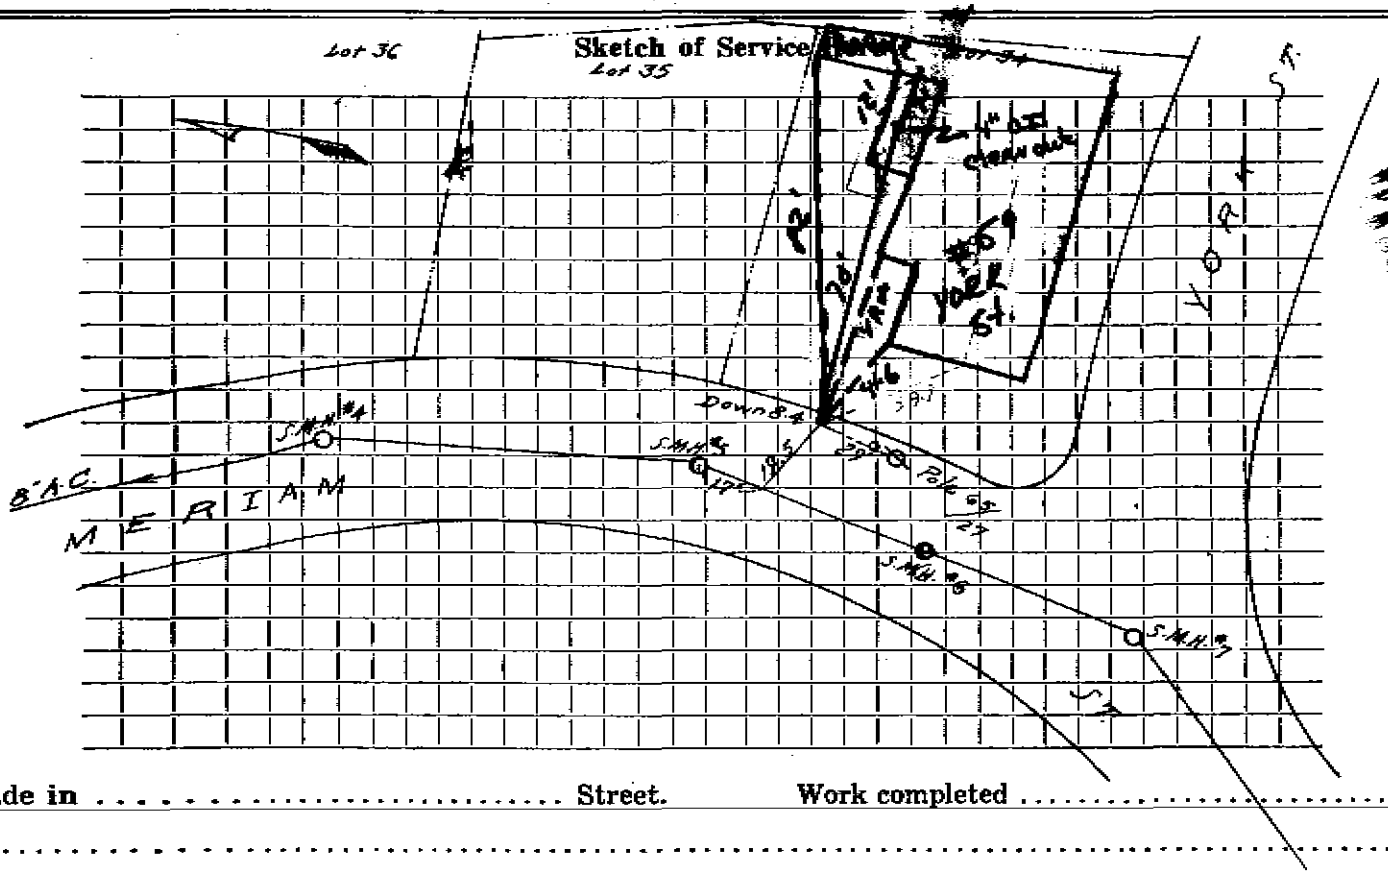

Connection made in ..... Street. Work completed .....

Remarks: .....

.....

.....