Name A Y A Realty Trust **Service No.** 172

Address 18 Young St.

Location

Kind of Pipe ACP **Size** 6" **Size of Main** 8"

Repair—Renewal—New Service ✓ Lax. Saworogo # 2379 **Location**

APR 8 1974

Date		Material	Amount		Total		Date			Amount	
8-17	73	21' @ $9.00	$189.	00			11-15-73		Deposit	189	00
11-14-	73	71'-6" ACP									
		8'-4" CI									

H.B.K.-18501

DATE

TOWN OF LEXINGTON — BOARD OF PUBLIC WORKS

SEWER DIVISION

Sketch of Service Here

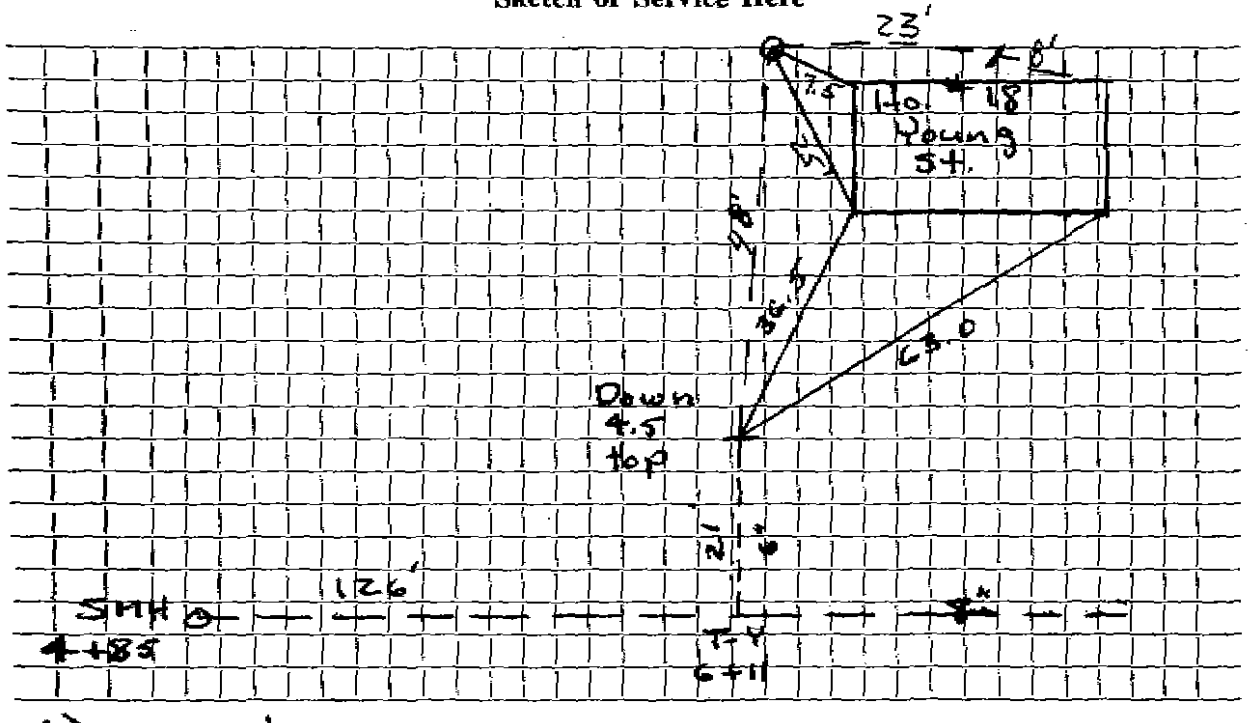

Connection made in Young St. Street. Work completed .....

Remarks: .....