Name Ann Boardman **Service No.** 156

Address 22 Young St.

Location

Kind of Pipe ACP **Size** 6" **Size of Main** 8"

Repair—Renewal—New Service ✓ Valerie Const. #2423 **Location**

APR 8 1974

Date		Material	Amount		Total		Date			Amount	
8-20	73	23' @ $9.00	207.	00			11-5-73		Deposit	207	00
11-16-	73	90' - 6" ACP									
		10' - 4" CI									

B.W.18501

DATE _____

TOWN OF LEXINGTON — BOARD OF PUBLIC WORKS

SEWER DIVISION

Sketch of Service Here

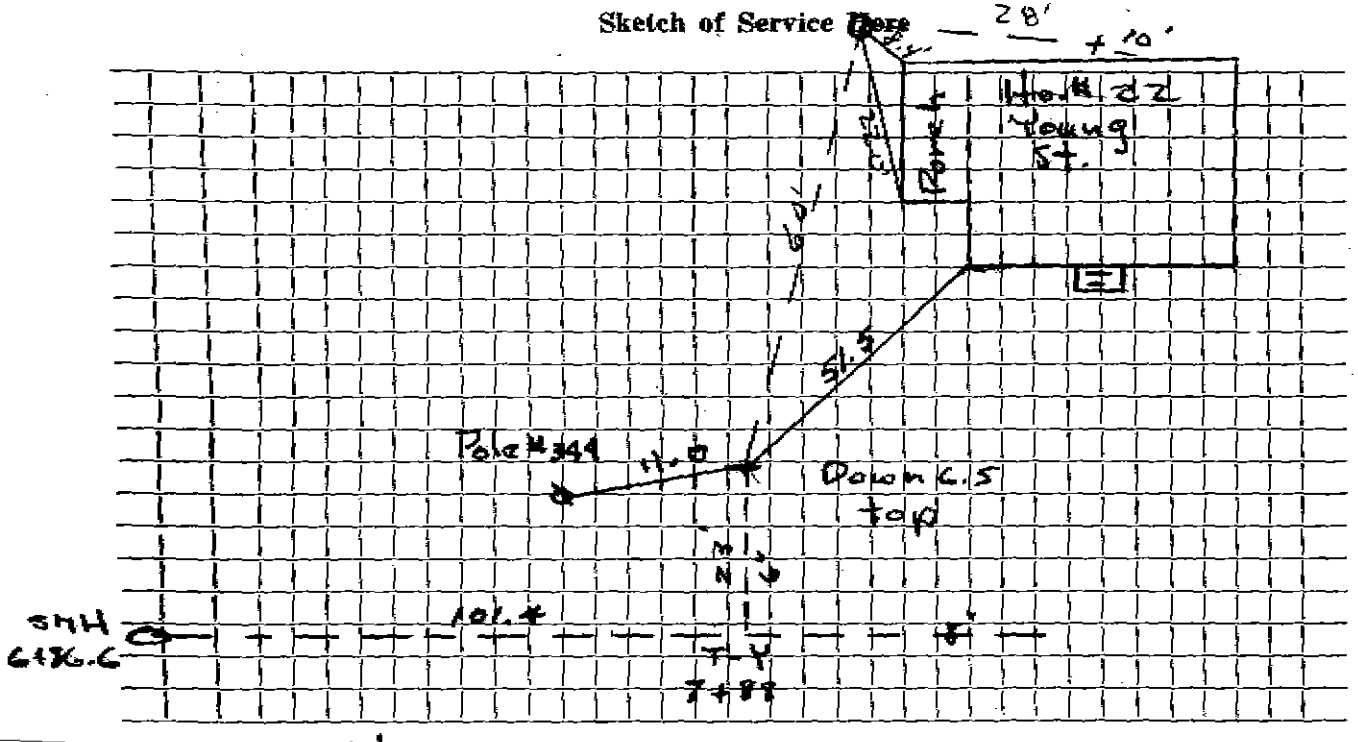

Connection made in Young St. Street. Work completed .....

Remarks: .....