Name Lawrence P. Zopatti **Service No.** 67(74)

Address 26 Young St.

Location

Kind of Pipe ACP **Size** 6" **Size of Main** 8"

Repair—Renewal—New Service Valeri #2569 **Location** AUG 16 1976

Date		Material	Amount		Total		Date		Amount	
8-17	73	23' @ 9.00	$207.	00			10/1/74	Deposit	207.	00
10/4/74	76'	6" Transite Pipe								
	5'	4" Cast Iron Pipe								

F.B.K.18501

DATE _____

TOWN OF LEXINGTON — BOARD OF PUBLIC WORKS

SEWER DIVISION

Sketch of Service Here

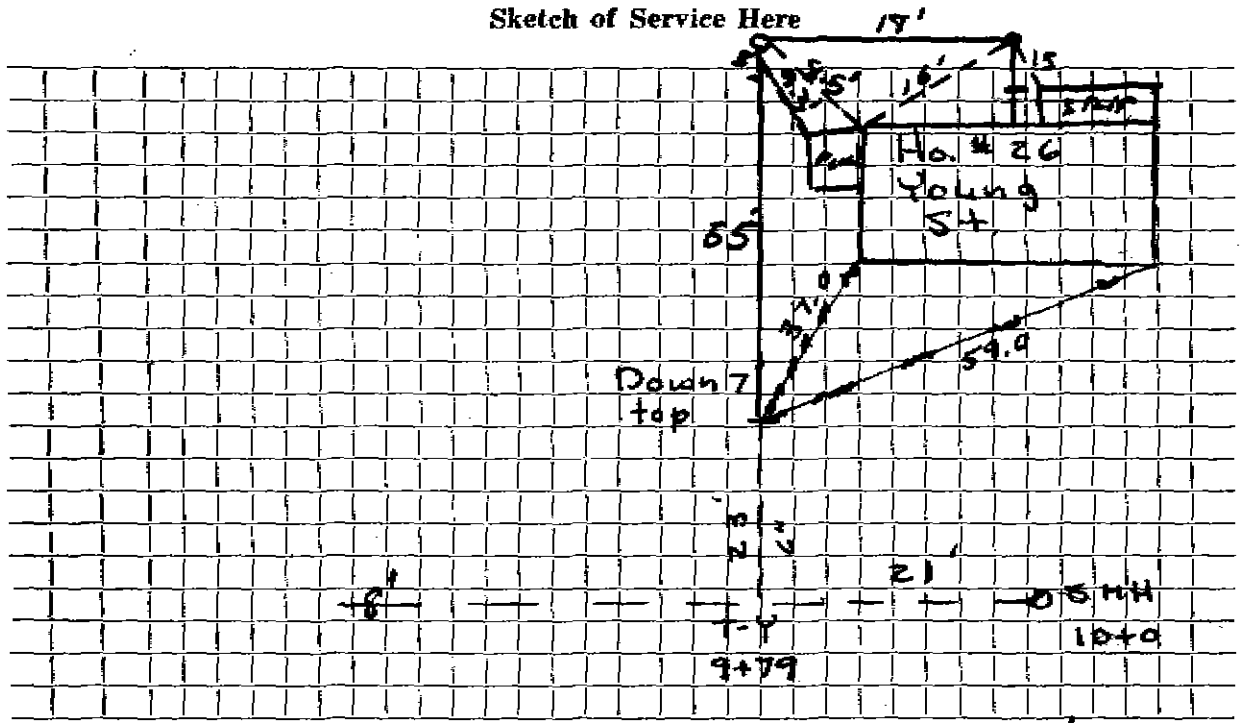

Connection made in 26 Young St. Street. Work completed 10/4/74

Remarks: