**Name** Chester Dunn **Service No.** 71 (74)

**Address** #30 Young Street

**Location**

**Kind of Pipe** **Size** **Size of Main**

**Repair—Renewal—New Service** Valeri #2573 **Location** AUG 16 1976

| Date | | Material | Amount | | Total | | Date | | | Amount | |
|---|---|---|---|---|---|---|---|---|---|---|---|
| | | | | | 180 00 | | | | | | |
| 8-10 | 74 | 20' 6" AC. | 9.00 | ft. | ~~180.00~~ | | 10/4/74 | | Deposit | 180. | 00 |
| 10/7/74 | 84' | 6" Transite Pipe | | | | | | | | | |
| | 55' | 4" Cast Iron | | | | | | | | | |

F.P.S.18601

DATE 8-10-74

# TOWN OF LEXINGTON — BOARD OF PUBLIC WORKS

## SEWER DIVISION

**Sketch of Service Here**

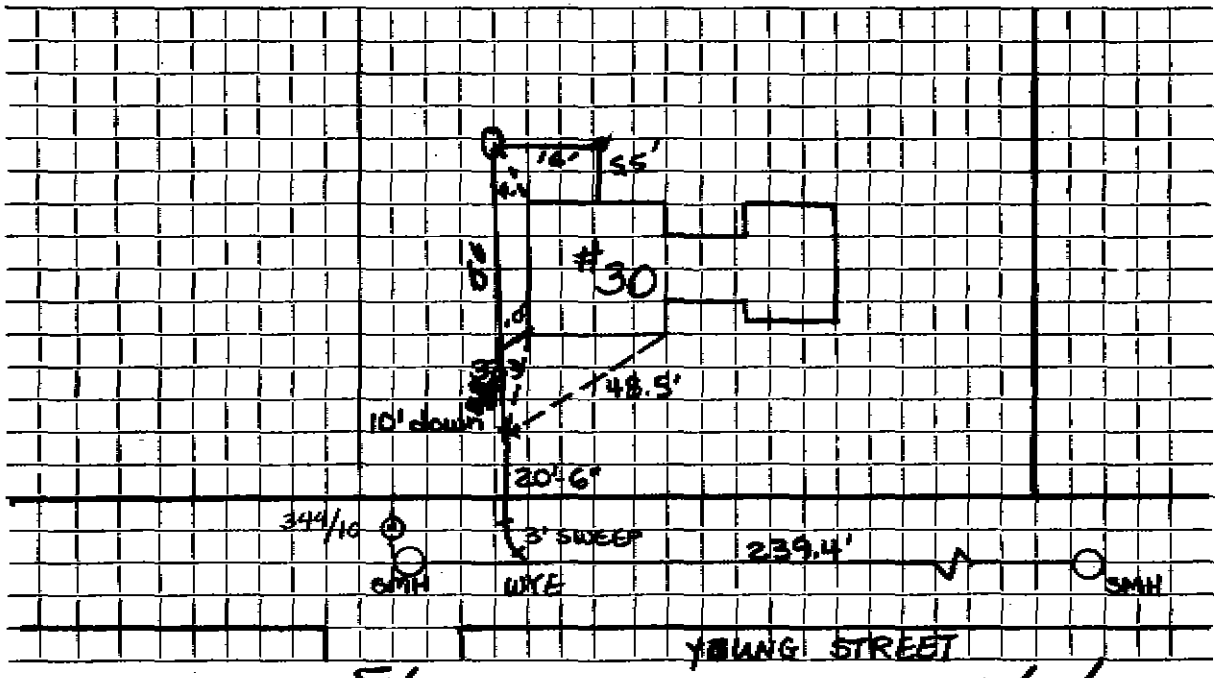


Connection made in 30 Young St. Street. Work completed 10/4/76

Remarks: