Name Arnold Miller

Service No. OK 74 (74)

Address #33 Young Street

Location

Kind of Pipe

Size 6" A.C.

Size of Main

Repair—Renewal—New Service Valeri #2576

Location AUG 16 1976

Date		Material	Amount		Total	Date		Amount
7-30	74	25[redacted]	9.00	ft.	32.00 [redacted]	9/7/74	Deposit	225.00
10/7/74	48'	6" Transite Pipe						
	5'	4" Cast Iron Pipe						

P.S.1850

DATE 7-30-74

TOWN OF LEXINGTON — BOARD OF PUBLIC WORKS

SEWER DIVISION

Sketch of Service Here

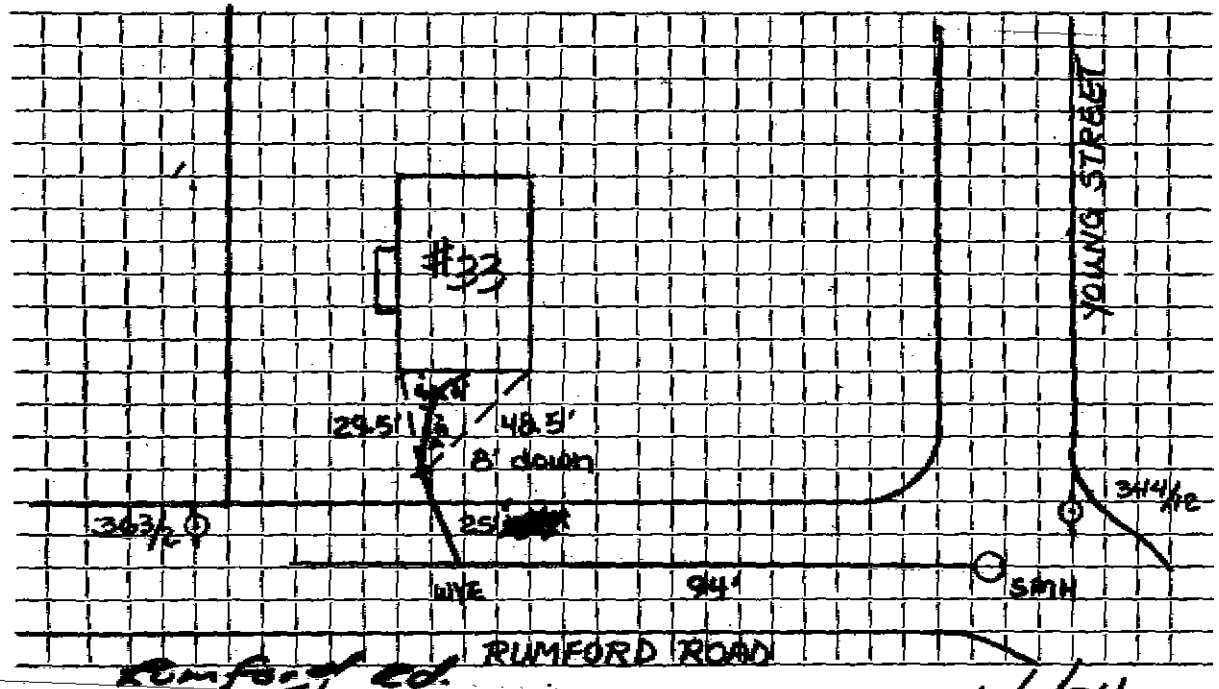

Connection made in Rumford Rd. Street. Work completed 14/7/74

Remarks: .....