WATER SERVICE RECORD

Name Robert E. Bayliss **Service No.** 2

Address 92 Adams Street

Location

~~Repair~~—Renewal—~~New Service~~ W.O. #1082 & W.C. #1083 JUN 23 1980

Date		INSIDE Material	Amount	Total	Date			Amount
3/19/80		Labor	15.00		3-19-80		Deposit	100.00
		10% O.H.	1.50	16.50			Refund	26.31
	35'	1" Copper tubing	@ .90	31.50				
	1	1" Wheel Handle S. & W		19.64				73.69
	1	1" x 3/4" Reducer		1.72			OUTSIDE	
	1	3/4" Brass Elbow		2.83	3/19/80		Labor	
	½	hr. Trucking		1.50		14'	1" Copper tubing	
				73.69		1	1" Curb	
						1	ton Cold Patch	
						2	hrs. Trucking	
						3	hr. Town Shovel	
						2	hrs. Tractor	

DATE _____

TOWN OF LEXINGTON — BOARD OF PUBLIC WORKS

WATER DIVISION

Sketch of Service Here

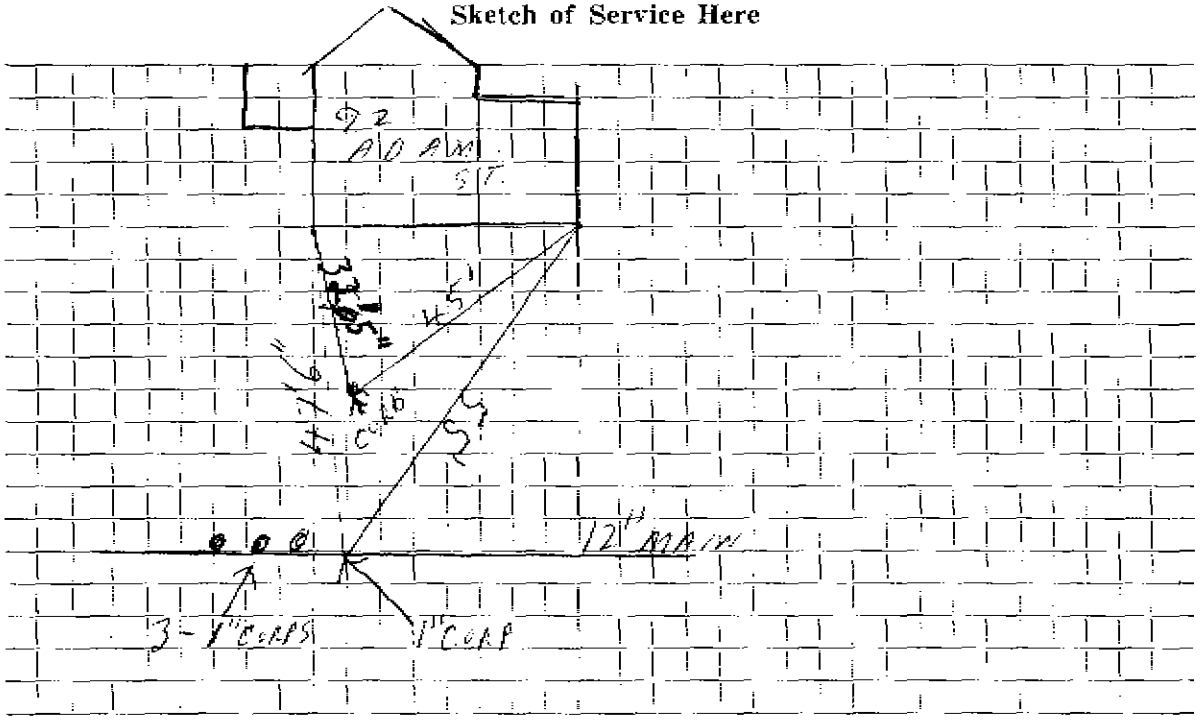

Connection made in ..... Street. Work completed .....

Remarks: 3.5 ft. — 1" Copper outside THK Copper inside 1" from right

14 ft. — 1" Copper outside