X.B.M.16010

~~[illegible]~~ 12598
2599

WATER SERVICE RECORD

Name Robert Ericson **Service No.** 26

Address 60 Allen Street

Location Kirkland & Shaw Permit #A294

~~[illegible]~~—**New Service** W.O.#2299

SEP 19 1966

Date		Material		Amount		Total		Date		Amount	
5-13-66		Labor	51.20					5-9-66	Deposit	100	00
5-25-66		Patching	32.60	83	80			1-10-67	Paid	74	09
		10% O.H.		8.38		92	18			174	09
	22'	3/4"copper tubing @.79				17	38				
	1	3/4" Curb				8	76				
	1	3/4" Corp.				7	42				
	300	lbs. cold patch @ 5.00 per ton					75				
	1	Box & Rod				5	10				
	2	Ton hot top @ 5.50				11	00				
	5	Hrs Town truck @ 3.00				15	00				
	2	Hrs. Tractor @ 6.50				13	00				
	½	Hr. Roller @ 3.00				1	50				
	1	Hr. Trailer				2	00				
						174	09				
5/13/66	101'	3/4" Copper tubing									
									Billed [illegible]		

DATE _____

TOWN OF LEXINGTON — BOARD OF PUBLIC WORKS

WATER DIVISION

Sketch of Service Here

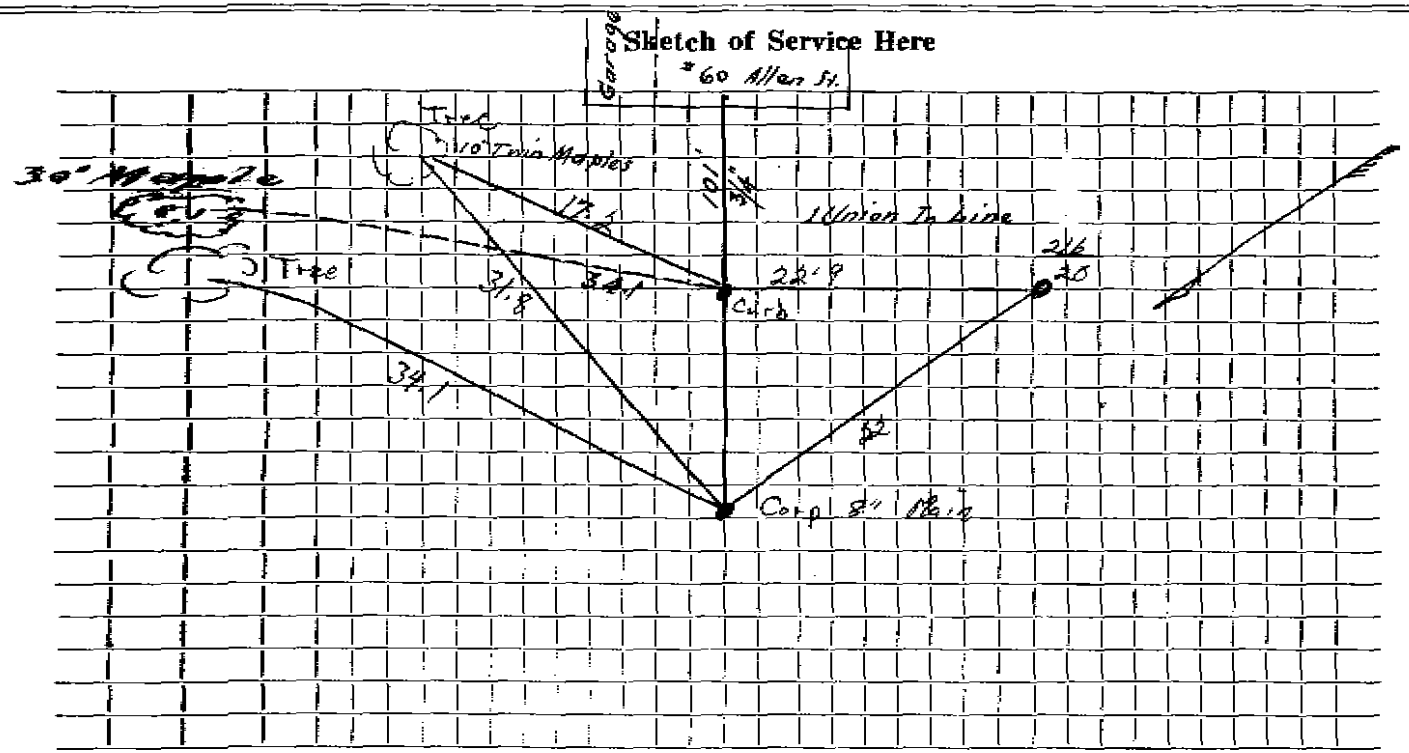

Connection made in . . . . . Street. Work completed . . . . . .

Remarks: . . . . . .

. . . . . .

. . . . . .