WATER SERVICE RECORD

Name **Service No.**

Address

Location 15 APPLETREE LA

Repair—Renewal—New Service

Date		Material	Amount	Total	Date			Amount
7/28/99	108'	1" COPPER			10/30/52	23'	3/4 COPPER	
		1" VALVE				1	3/4 CORP	
	1	3/4 X 1" UNION COMP				1	3/4 CURB	
	1	1" SWEET UNION						
	1	Buffalo Box						

DATE _____

TOWN OF LEXINGTON — BOARD OF PUBLIC WORKS

WATER DIVISION

Sketch of Service Here

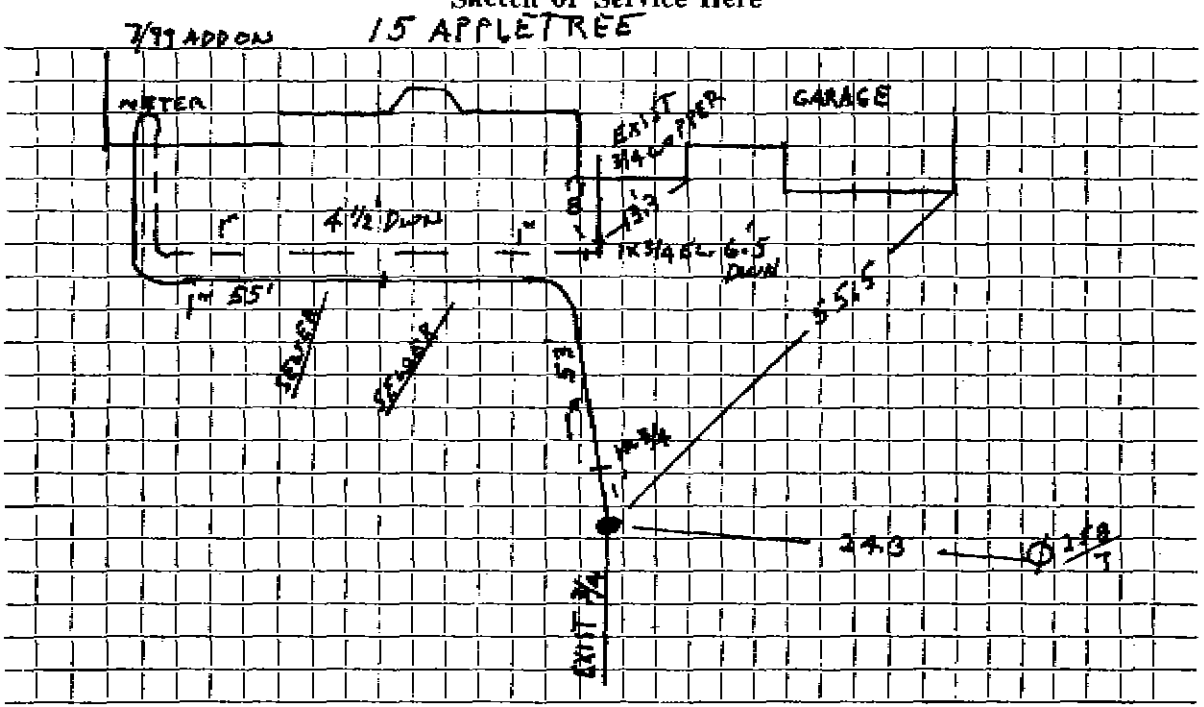

Connection made in ..... Street. Work completed .....

Remarks: SWEET UNION, WATER UNDER SEWER