WATER SERVICE RECORD

Name **Service No.**

Address 6 April Lane

Location

Repair—Renewal—New Service

Date	Material	Amount	Total	Date		Amount

DATE _____

TOWN OF LEXINGTON — BOARD OF PUBLIC WORKS

WATER DIVISION

Sketch of Service Here

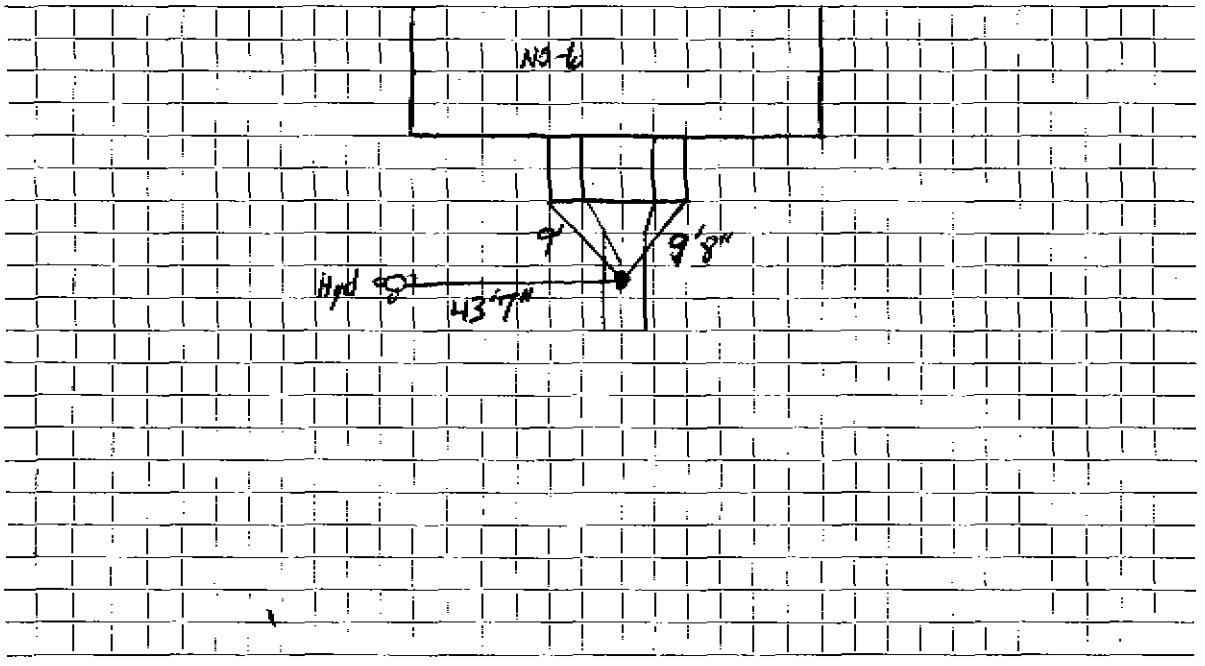

Connection made in ..... Street. Work completed .....

Remarks: .....

.....

.....