WATER SERVICE RECORD

Name **Service No.**

Address 4 Augustus Rd

Location

Repair—Renewal—New Service

Date	Material	Amount	Total	Date		Amount
8/16/17	1" copper pipe					
	1" curb stop	1				
	3/4" curb stop	BURRYED				
	18" x 1" tail piece	1				
	depth = 4'					
	Type K					
	camb. brass					
	open right					

DATE 8/16/87

TOWN OF LEXINGTON — BOARD OF PUBLIC WORKS

WATER DIVISION

Sketch of Service Here

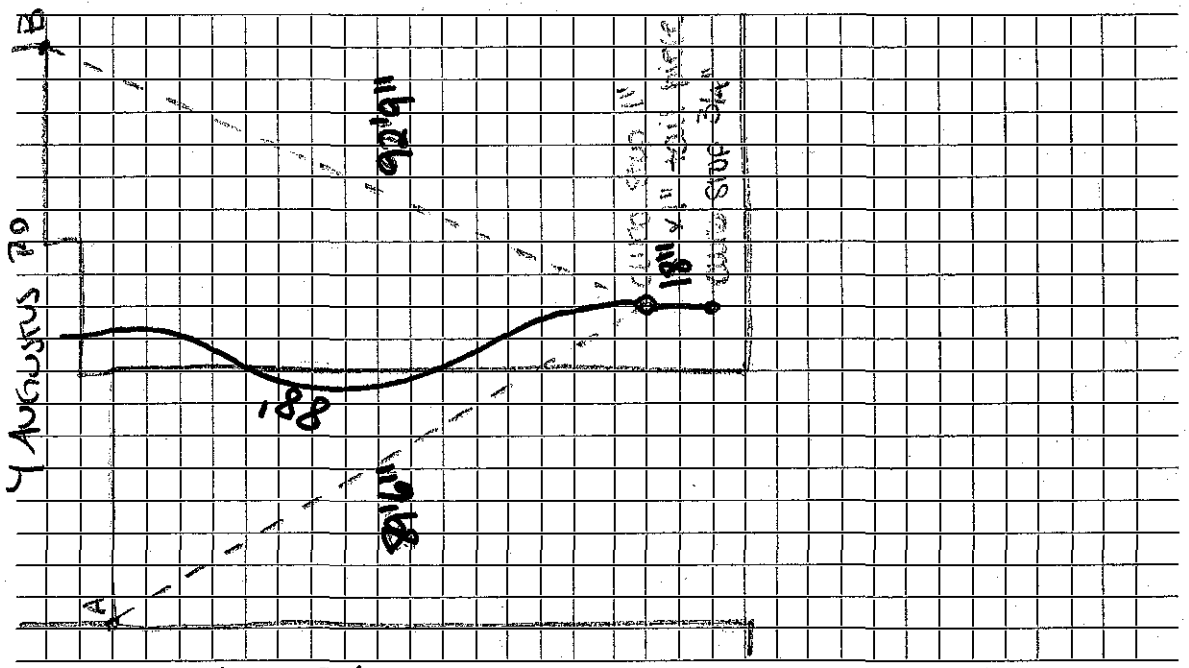

Connection made in Augustus Rd Street. Work completed .....

Remarks: .....