S.B.R.16010

#5303

WATER SERVICE RECORD

Name Donna Realty Trust **Service No.** 30

Address 49 Balfour Street

Location John E. Grant #A317

[redacted] New Service W.O. #2378

SEP 19 1966

Date		Material	Amount		Total		Date		Amount	
6-1-66		Labor	26	46			5-16-66	Deposit	75	00
		10% O.H.	2	65	29	11	9-19-66	Refund	9	92
	11'	3/4" copper tubing @.79			8	69			65	08
	1	Curb Cock			8	76				
	1	Corp. Cock			7	42				
	1	Box & Rod			5	10				
	2	Hrs. Town Truck @ 3.00			6	00				
					$65	08				
6/1/66	32.5'	3/4" Copper tubing								

DATE _____

TOWN OF LEXINGTON — BOARD OF PUBLIC WORKS

WATER DIVISION

Sketch of Service Here

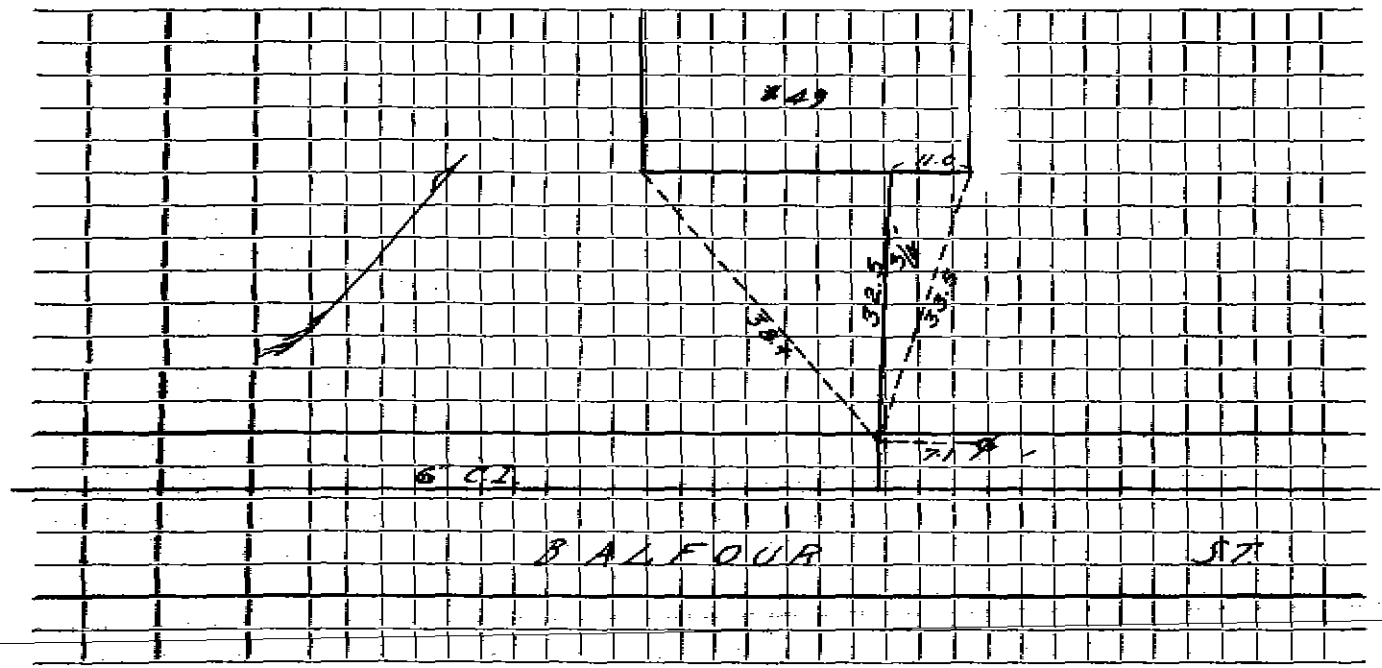

Connection made in ..... **Street.** **Work completed** .....

Remarks: .....

.....

.....