S.P.N.16010

WATER SERVICE RECORD

Name Nick Bonanno **Service No.**

Address 6 Barrett Road

Location

Repair—Renewal—New Service Bonano #1865
Bonanno # 1687

Date		Material	Amount	Total	Date		Amount
7/30/70	34'	3/4" Copper					
7/7/71	23.5'	3/4" Copper tubing					

DATE _____

TOWN OF LEXINGTON — BOARD OF PUBLIC WORKS

WATER DIVISION

Sketch of Service Here

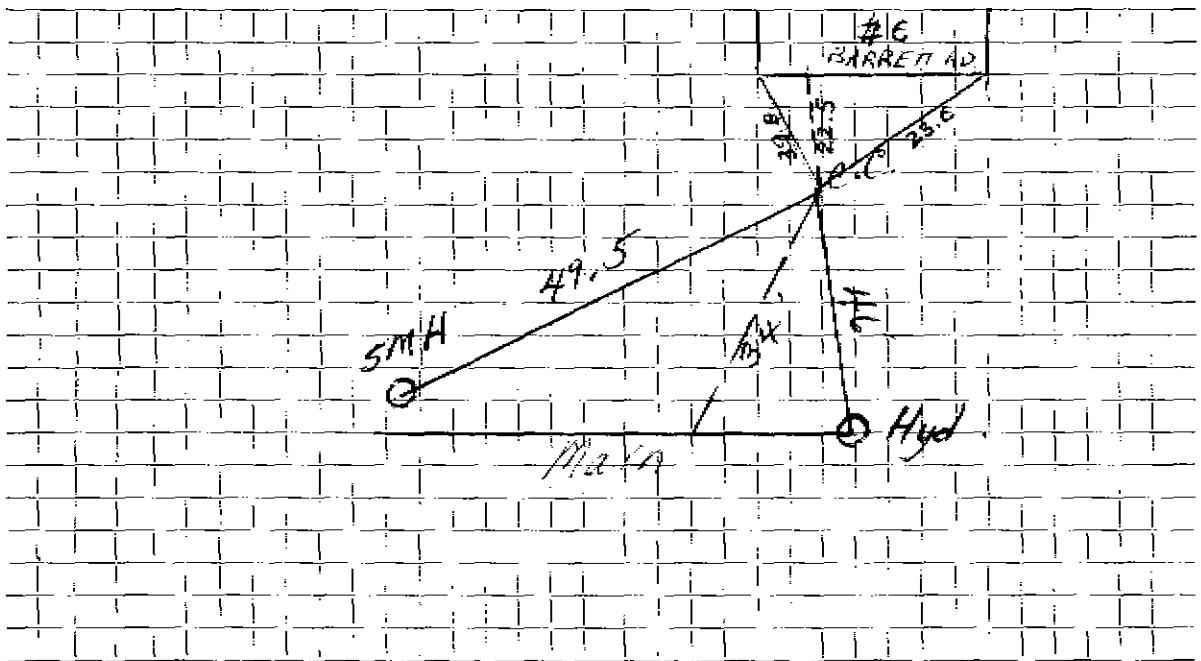

Connection made in ..... Street. Work completed .....

Remarks: .....

.....

.....