B.B.M.16010

WATER SERVICE RECORD

Name Louis Esposito **Service No.** 375 (1956)

Address 116 Bedford Street

Location

~~Repair~~ ~~Renewal~~ ~~New Service~~ Comm. 3/18/57

Date		Material	Amount	Total	Date		Amount
12-5-56		Labor	3.90		12-5-56	Deposit	$ 50.00
		10% O.H.	.39	4.29	3-18-57	Refund	[illegible]
	48'	3/4" Copper tubing @.4396		21.10			$ 3[illegible].10
	1	3/4 C x ½ I.W.H. Stop & Waste		4.96			
	1	hr. Trucking @.75		.75			
				31.10			

DATE_____

TOWN OF LEXINGTON — BOARD OF PUBLIC WORKS

WATER DIVISION

Sketch of Service Here

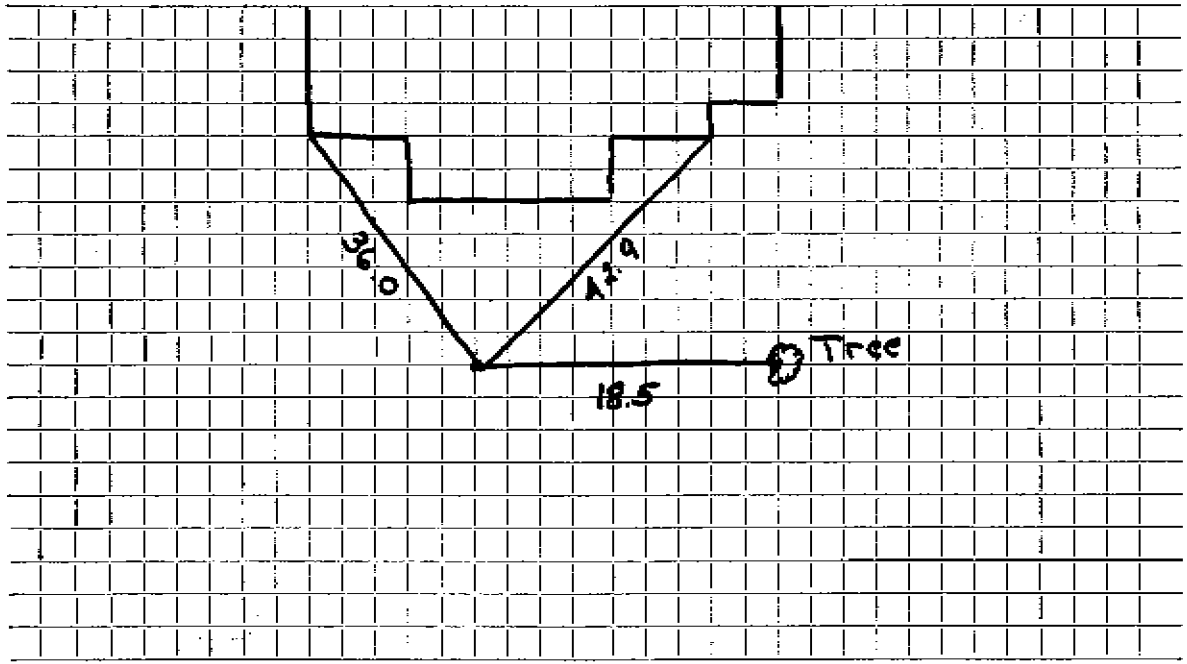

Connection made in ..... Street. Work completed .....

Remarks: .....

.....

.....