WATER SERVICE RECORD

Name | **Service No.**

Address

Location 292 BEDFORD ST

Repair—Renewal—New Service

Date		Material	Amount	Total	Date			Amount
1942	9-14				9-9	42		
	1	1" I x 3/4" S+W				10'	3/4 COPPER	
	1	3/4 x 1/2 BUSHING				1	3/4 CORP	
	1	1" L.L. ELBOW				1	3/4" COPPER x 1" IRON CURB COCK	

DATE _____

TOWN OF LEXINGTON — BOARD OF PUBLIC WORKS

WATER DIVISION

Sketch of Service Here

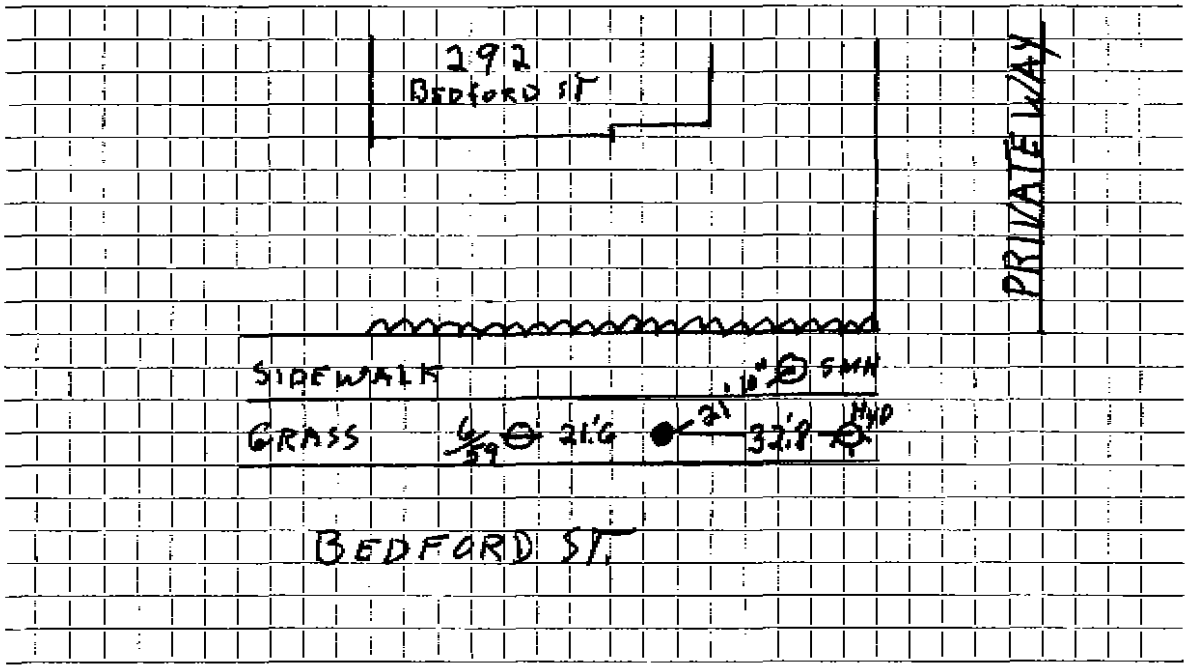

Connection made in ..... Street. Work completed .....

Remarks: .....

.....

.....