WATER SERVICE RECORD

Name John R. Clarke Assoc. Inc. **Service No.**

Address 314 Bedford Street

Location

Repair—Renewal—New Service Leonco Inc. #3683

Date	Material	Amount	Total	Date		Amount
					OUTSIDE	
				11/13/81	11'6" 4" D.I.P.	
					1 12" x 4" Tap Sleeve & Gate	
					2 90° Elbows 4"	

DATE _____

TOWN OF LEXINGTON — BOARD OF PUBLIC WORKS

WATER DIVISION

Sketch of Service Here

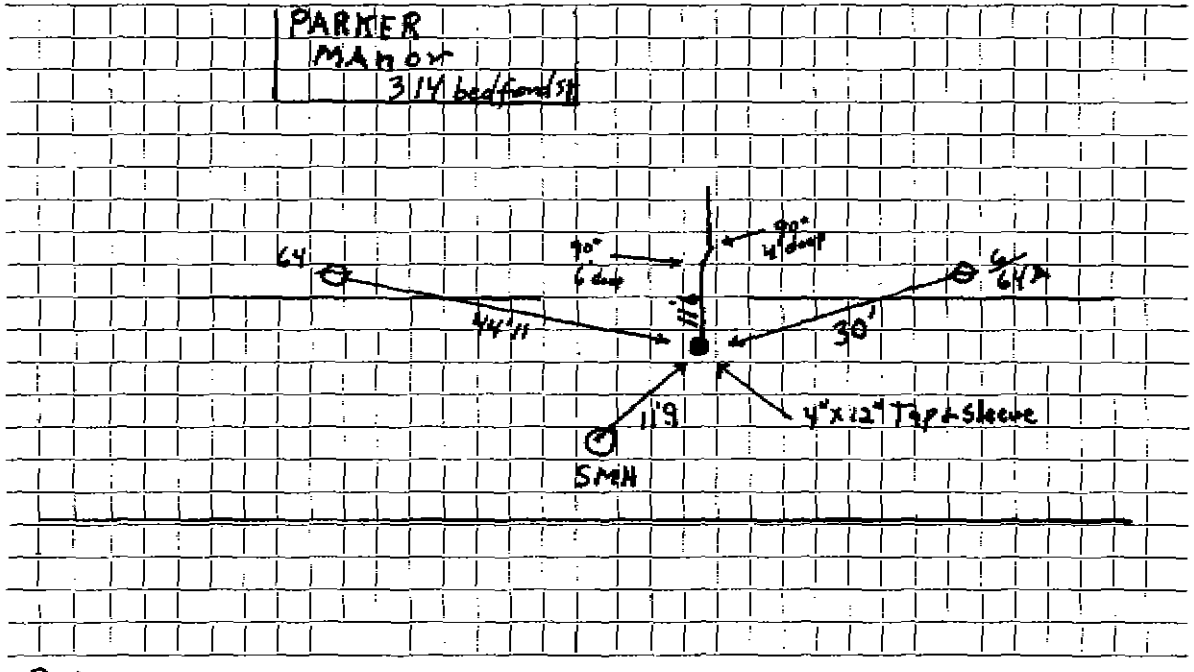

Connection made in Bedford ST. Joe Mellin Street. Work completed .....

Remarks: .....