WATER SERVICE RECORD

Name *Moore Homes* Service No.

Address *768 Bedford Street*

Location

~~Repair~~ ~~Renewal~~ New Service *J. Melone & Sons #4000*

Date		Material	Amount	Total	Date		Amount
9/24/85	*23'*	*2" Copper*					
		6" x 2" Service Saddle					
		2" Curb Stop					
		2" Corp					
		Sprinkler					
	59'	*6" D.I.P.*					
		12" x 6" Tap Sleeve & Gate					
	1	*6" x 6" x 6" Tee*					
	2	*6" Gates*					
	3	*Gate Boxes*					

DATE _____

TOWN OF LEXINGTON — BOARD OF PUBLIC WORKS

WATER DIVISION

Sketch of Service Here

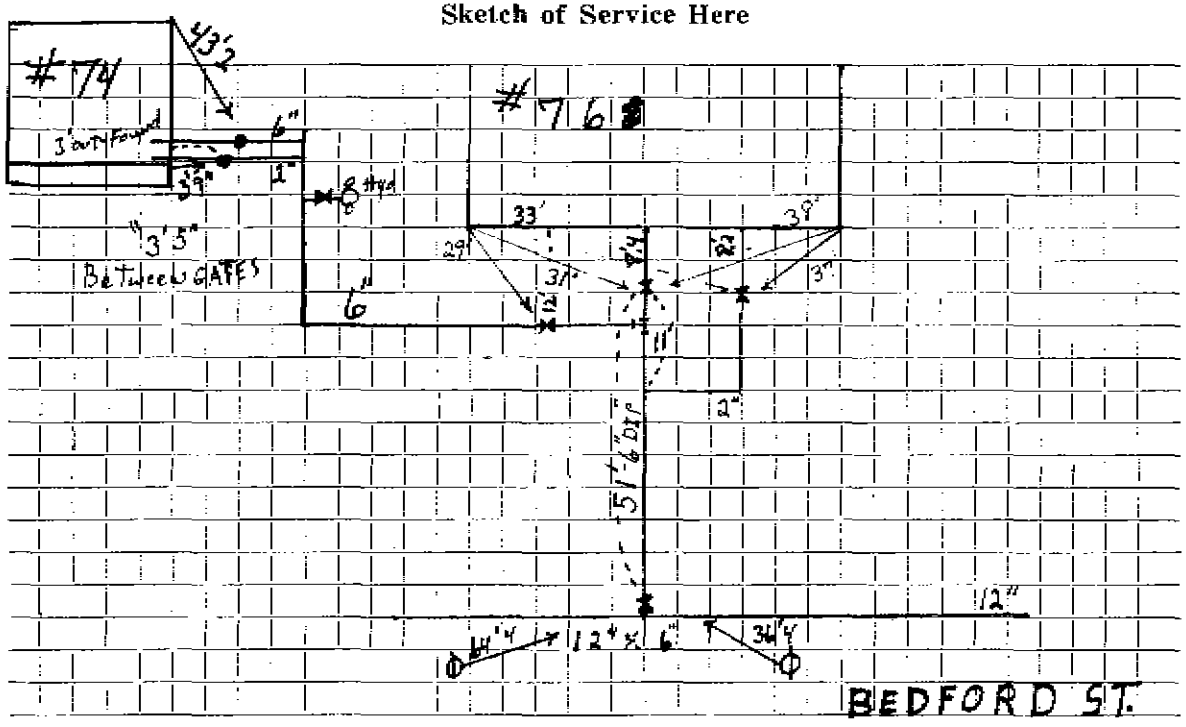

Connection made in ..... Street. Work completed .....

Remarks: Gates for #74 and #76 are about 4ft apart