WATER SERVICE RECORD

Name CEMETERY DEPT

Service No.

Address

Location BEDFORD ST

Repair—Renewal—New Service

Date		Material	Amount	Total	Date		Amount
10-31-90							
	1	1" Curb Comp.					
	1	1" Tee Comp					
	1	1¼" Dresser Cplg.					
	1	1¼x6" nipple					
	1	1¼x1" Reducer					
	1	1" MxC					
	1	1" 90° EL					
	1	RD. WAY Box					

DATE _____

TOWN OF LEXINGTON — BOARD OF PUBLIC WORKS

WATER DIVISION

Sketch of Service Here

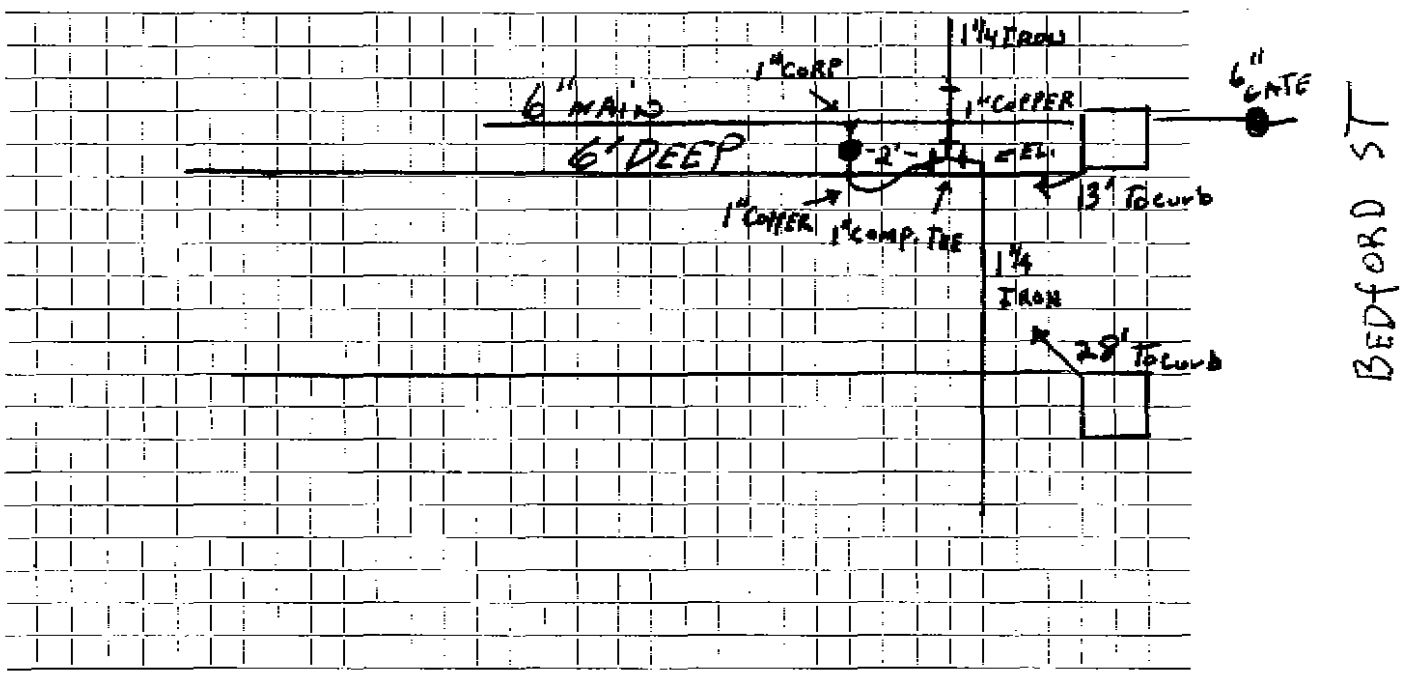

Connection made in ..... Street. Work completed .....

Remarks: 1-1" COPPER FEEDS BOTH 1¼" IRON PIPES .....

.....

.....