WATER SERVICE RECORD

Name CORNERSTONE CONCEPTS

Service No. 4484

Address 4 BENJAMIN Rd

PERMIT 1499

Location

Repair—Renewal—New Service

Date		Material	Amount		Total		Date		OUTSIDE	Amount	
10-00	00	INSIDE					11-30	51	10"-3/4" COPPER		
		42' 1" COPPER							1-3/4" CORP		
		3/4X1" ADAPT.							1-3/4" CURB		

DATE _____

TOWN OF LEXINGTON — BOARD OF PUBLIC WORKS

WATER DIVISION

Sketch of Service Here

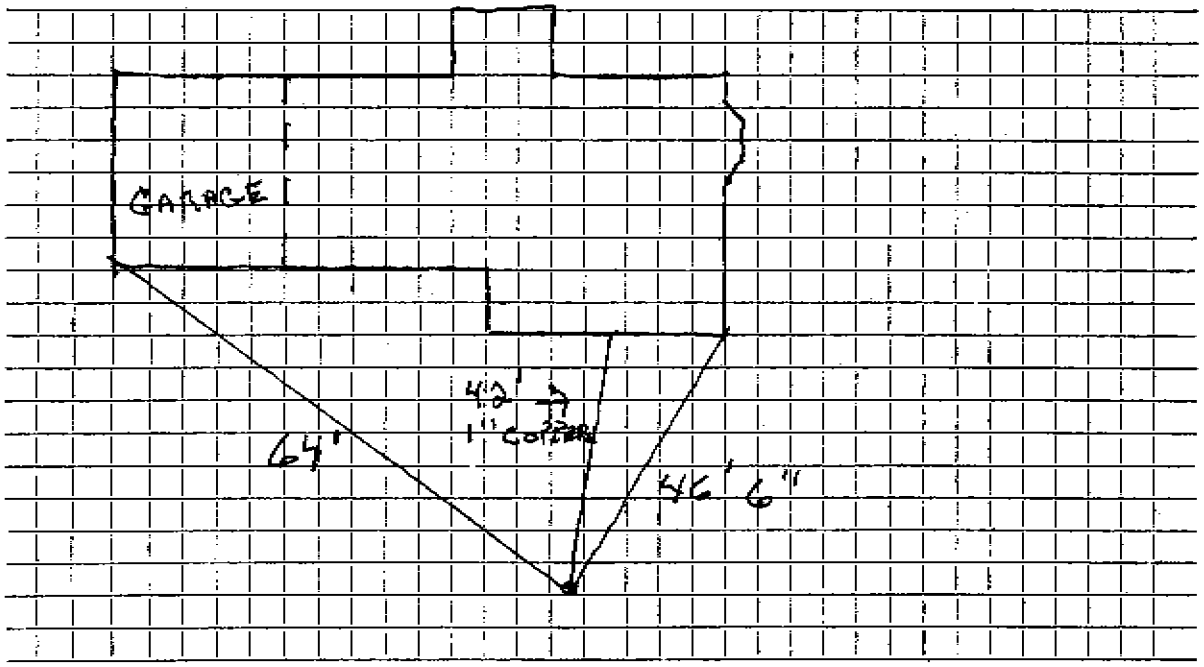

Connection made in BENJAMIN Rd. Street. Work completed 10-2000

Remarks: J.M. McLAUGHLIN CONST.