WATER SERVICE RECORD

Name Ulysse Bourque **Service No.**

Address 4 Berwick Road

Location

~~Repair~~ ~~Renewal~~ **New Service** Cincotta #3482

Date		Material	Amount	Total	Date			Amount
5/12/80	42.5	1" Copper tubing (inside)						
	1	1" Corp. - 4' 4" Deep						
	1	1" Curb Stop - 5' 6" Deep						
	1	Box & Rod					OUTSIDE	
					5/12/80	35'	1" Copper tubing	
							Patch 14' x 28'	

DATE _____

TOWN OF LEXINGTON — BOARD OF PUBLIC WORKS

WATER DIVISION

Sketch of Service Here

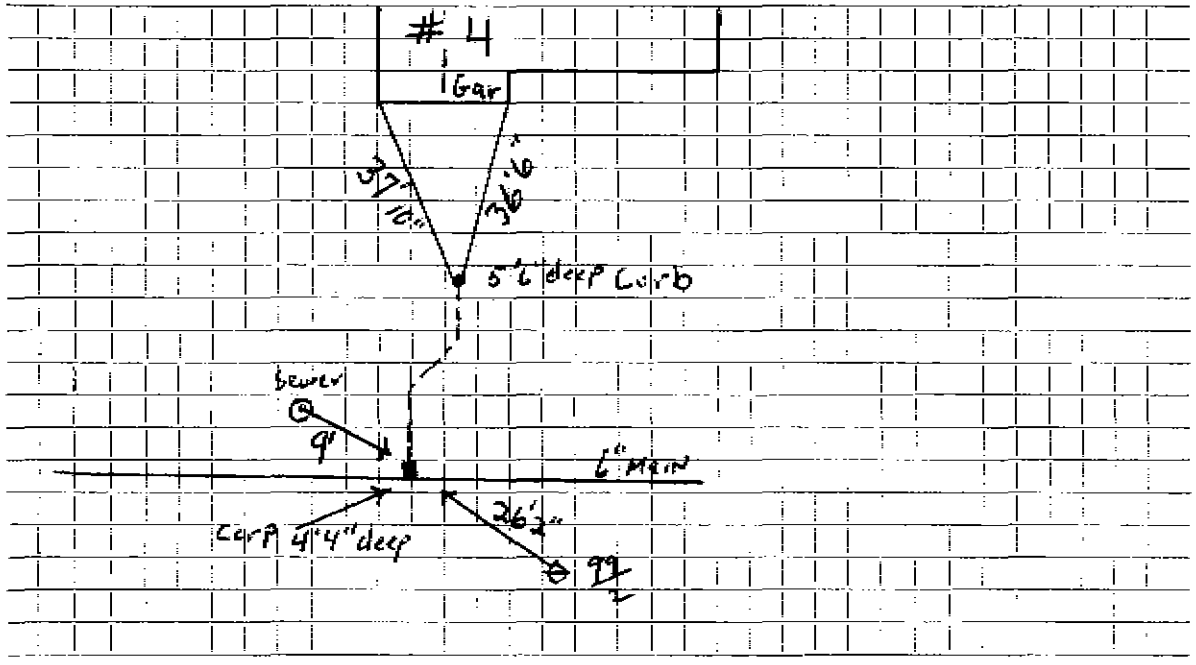

Connection made in ..... Street. Work completed .....

Remarks: .....

.....

.....