F.3.N.25010

WATER SERVICE RECORD

Name

Service No.

Address #2 BICENTENNIAL DR.

Location

Repair—Renewal—New Service Eagle #3294

Date	Material	Amount	Total	Date		Amount
6/5/77	38' - 1" COPPER					

DATE _____

TOWN OF LEXINGTON — BOARD OF PUBLIC WORKS

WATER DIVISION

Sketch of Service Here

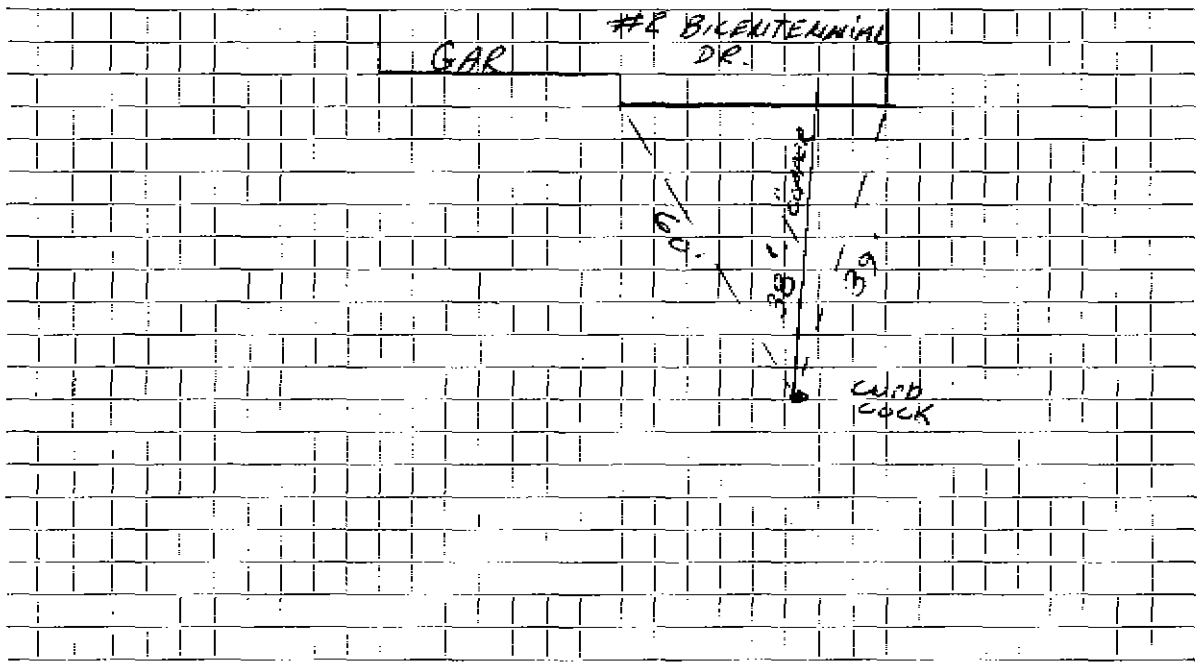

Connection made in BICENTENNIAL DR., ~~Street.~~ Work completed .....

Remarks: .....

.....

.....