R.B.M.16010

#2006

WATER SERVICE RECORD

Name J. Frank Busa **Service No.**

Address 7 Birch Hill Lane

Location Lot #26

Repair—Renewal—New Service Lucente #791

Date		Material	Amount		Total		Date			Amount	
	70'	Copper tubing									

DATE _____

TOWN OF LEXINGTON — BOARD OF PUBLIC WORKS

WATER DIVISION

Sketch of Service Here

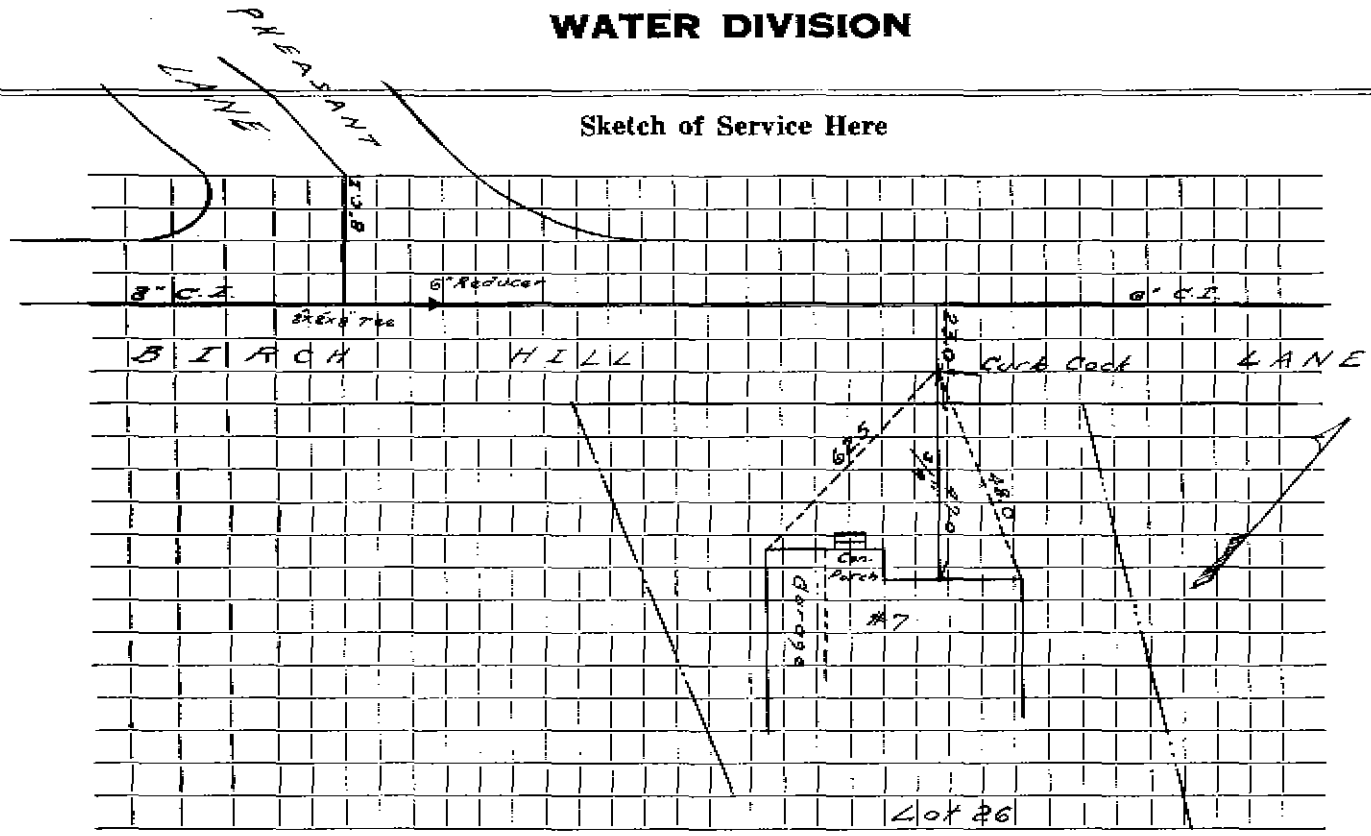

Connection made in ..... Street. Work completed .....

Remarks: .....

.....

.....