WATER SERVICE RECORD

Name

Service No.

Address 15 Bird Hill RD

Location

LOT 26

Repair—Renewal—New Service

Date		Material	Amount	Total	Date		PAO Corp	Amount
10/27/61	20'	3/4 copper			7/27/09	10'	1" Copper	
		3/4 x 1/2 saw					1" Corp	paid 4.3
							1" Curb STOP	" 4.0
							1" x 3/4 Red	
							buffalo box	

DATE _____

TOWN OF LEXINGTON — BOARD OF PUBLIC WORKS

WATER DIVISION

Sketch of Service Here

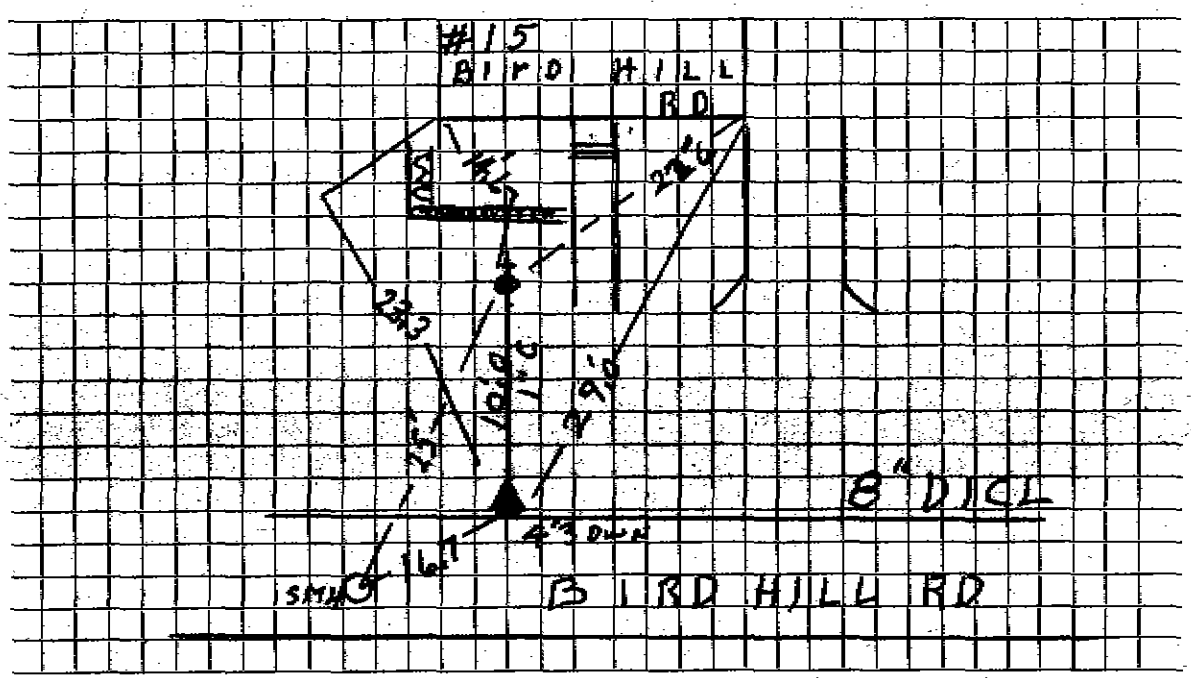

Connection made in ..... Street. Work completed 7/27/09 PAO Corp

Remarks: Curb Dwn 4.0