WATER SERVICE RECORD

Name

Service No.

Address 20 Bird Hill RD

Location

LoT 29A

Repair—Renewal—New Service

Date		Material	Amount	Total	Date		PAO	Amount
4/14/02	73'	1" Copper			7/28/09	36'	1" Copper	
	1-	1" 3-part Union					1" Corp	pwr 4.5
							1" Curb Stop	pwr 4.6
							1"x1" Union	
							buffle box	

DATE _____

TOWN OF LEXINGTON — BOARD OF PUBLIC WORKS

WATER DIVISION

Sketch of Service Here

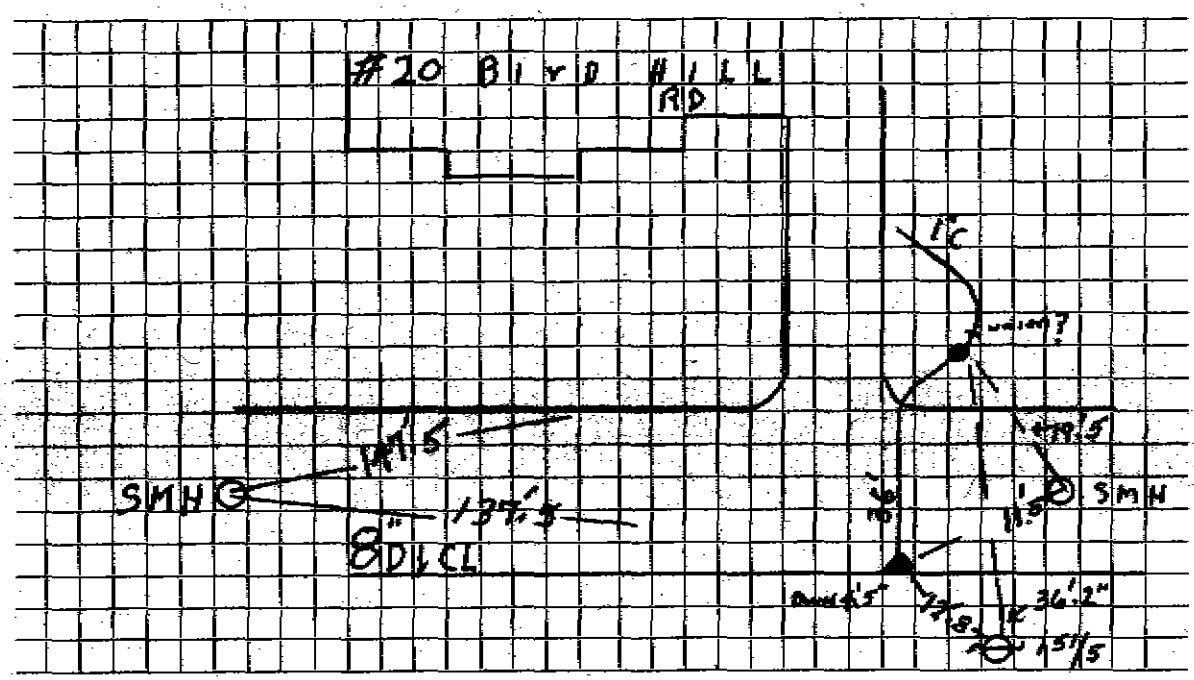

Connection made in Bird Hill Street. Work completed 7/28/09 P.A.O.

Remarks: Curb Dun 4'6"