HP-676

WATER SERVICE RECORD

Name Bertram Gustin **Service No.** 200 N. S.

Address 50 Bloomfield St. #3198

Location

~~Repair~~—Renewal—~~New Service~~ xx Com. 8-15-55

Date	Material	Amount	Total	Date		Amount
6/6/55	Labor	62 80			No Deposit	
	10% Overhead	6 28	69 08	11-1-55	Paid	118 30
	75' - 3/4" Copper tubing @ .36	93	27 75			
	1 - 3/4" c x ½ I.W.H. stop & waste		4 00			
	1 - 3/4" C x 3/4" C. Union 3 pts		1 72			
	2 hrs. Littlefield shovel @ 7.50		15 00			
	1 hr. trucking		75			
			118 30			

Cust. 8-16-55

DATE _____

TOWN OF LEXINGTON — BOARD OF PUBLIC WORKS

WATER DIVISION

Sketch of Service Here

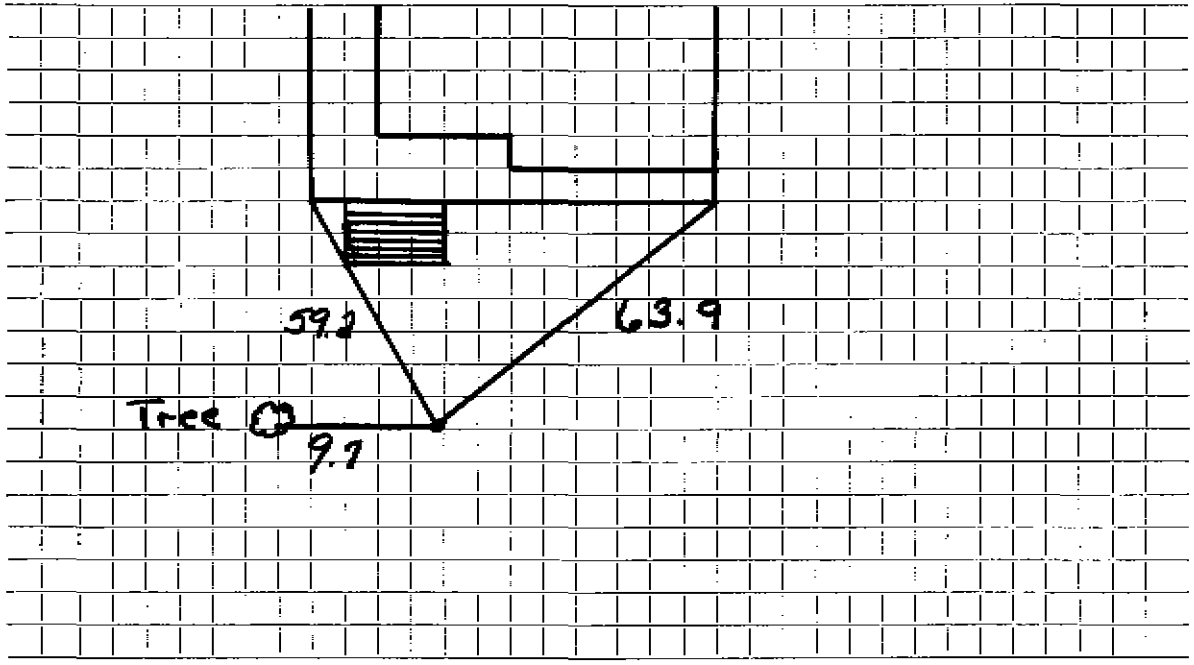

Connection made in ..... Street. Work completed .....

Remarks: .....

.....

.....