S.S.N.16010

WATER SERVICE RECORD

Name S & A Realty Trust **Service No.**

Address 82 Bloomfield Street

Location Sta.0+70L Lot #1

~~**Service Renewal**~~ **New Service** J.M.Lucente Permit #352

Date		Material	Amount		Total		Date			Amount	
6-25-65	52'	3/4" Copper tubing									

DATE _____

TOWN OF LEXINGTON — BOARD OF PUBLIC WORKS

WATER DIVISION

Sketch of Service Here

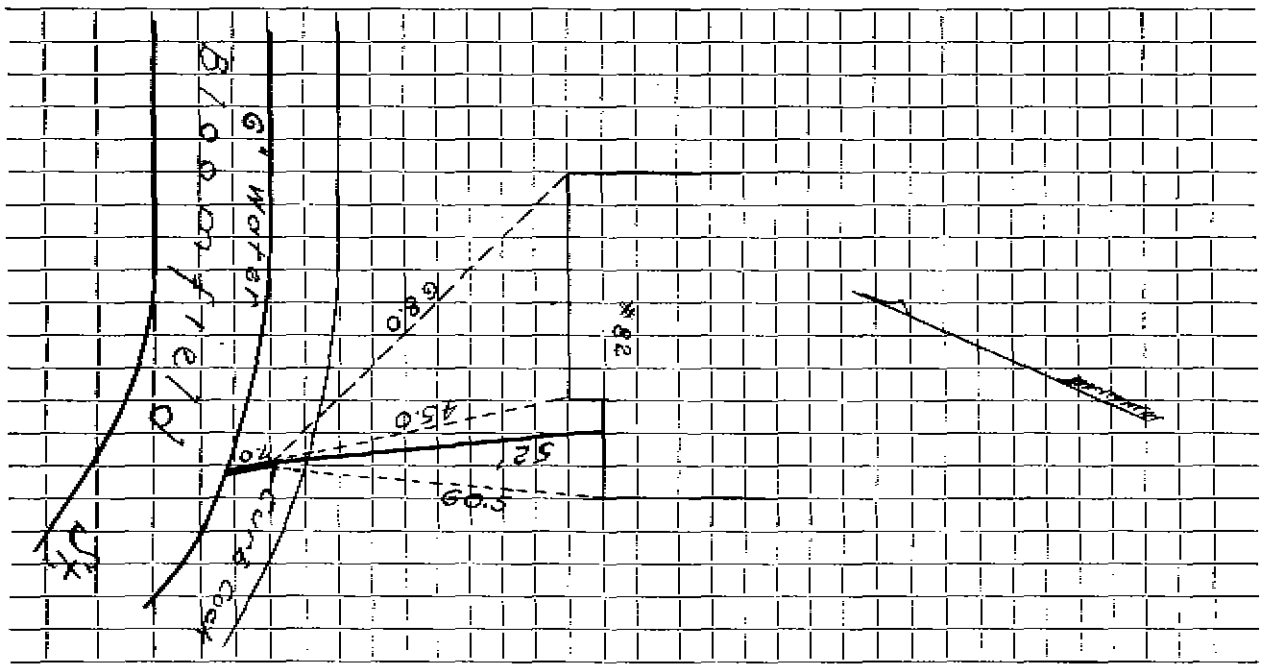

Connection made in ..... Street. Work completed .....

Remarks: .....

.....

.....