WATER SERVICE RECORD

Name

Service No. 1503

Address 23 Blossomcrest RD

Location

Repair—Renewal—New Service J. McLaughlin

Date		Material	Amount	Total	Date		Exist	Amount
7/28/04	47'	1" Copper			4/22/52	8'	3/4 Copper	
		3/4x1" Inverser					3/4 Corp	
		buffalo box					3/4 Curb Stop	

DATE _____

TOWN OF LEXINGTON — BOARD OF PUBLIC WORKS

WATER DIVISION

Sketch of Service Here

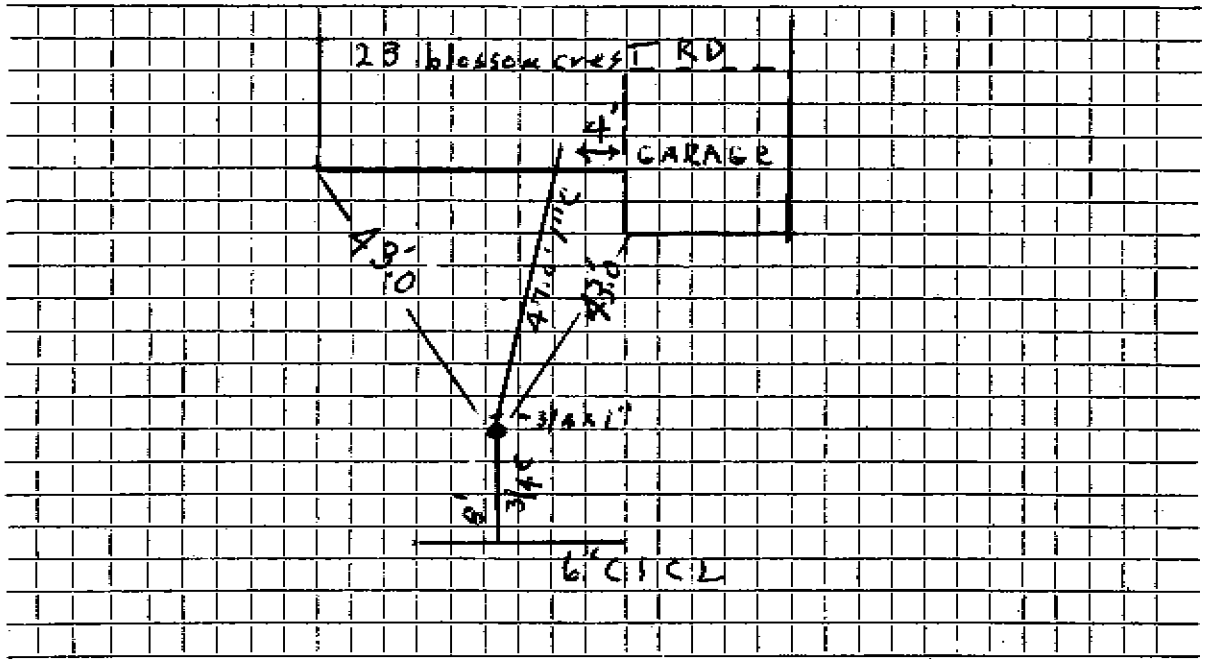

Connection made in ..... Street. Work completed 12/28/04

Remarks: .....