WATER SERVICE RECORD

Name George Grey bexToyoTa

Service No.

Address 11 Bow Ker ST

Location

LoT 318A

Repair—Renewal—New Service

Date		Material	Amount	Total	Date		P.A.O. Corp	Amount
7/28/86	110'	1" Copper			9/10/09	14'	1" Copper	
	1	1" Flare Union					1" Corp	
	1	1"x1" Copper x Female Union					1" Curb Stop	
							buffalo box	

DATE _____

TOWN OF LEXINGTON — BOARD OF PUBLIC WORKS

WATER DIVISION

Sketch of Service Here

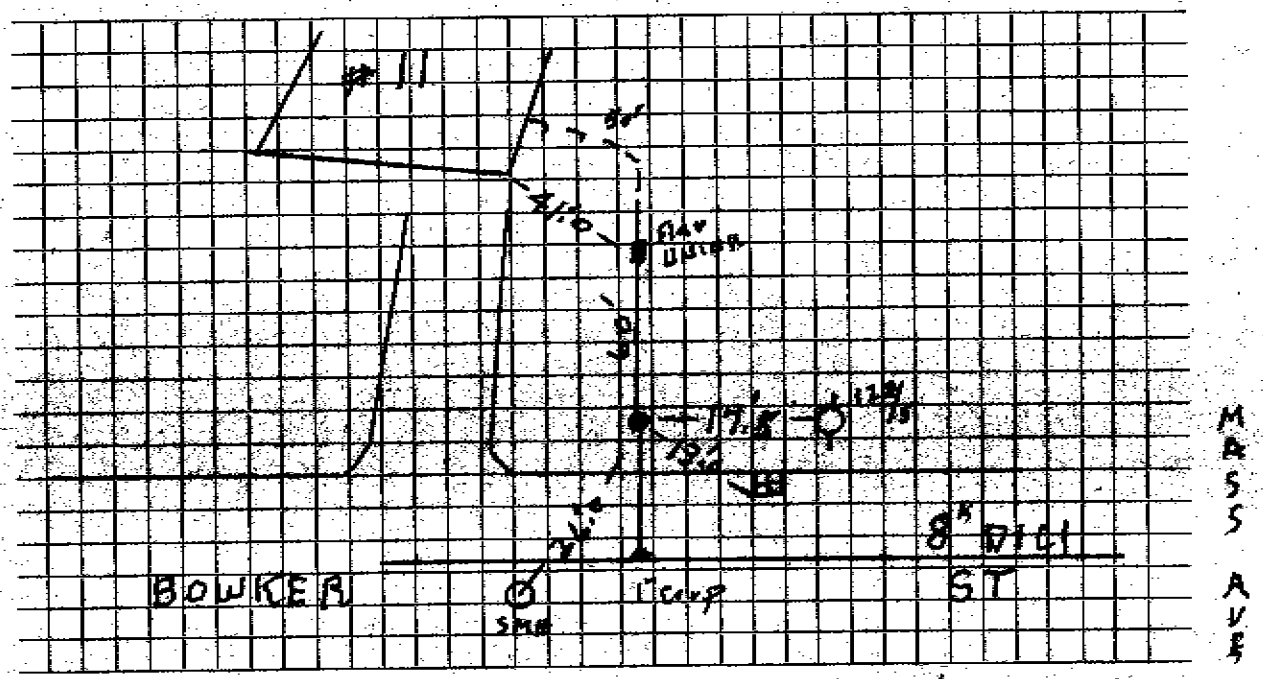

Connection made in ..... Street. Work completed 9/10/09 P.A.O. Corp.

Remarks: .....