WATER SERVICE RECORD

Name

Service No.

Address 22 Bowker ST

Location

LOT 283.C

Repair—Renewal—New Service

Date		Material	Amount	Total	Date		P.A.O Corp.	Amount
12/22/31	18'	3/4 Copper			9/14/09	17'	1" Copper	
		3/4 S&W				4'	1" Copper	
							1" Corp	
							1" Curb Stop	
							1"x3/4 Reducer	
							buffalo box	

DATE _____

TOWN OF LEXINGTON — BOARD OF PUBLIC WORKS

WATER DIVISION

Sketch of Service Here

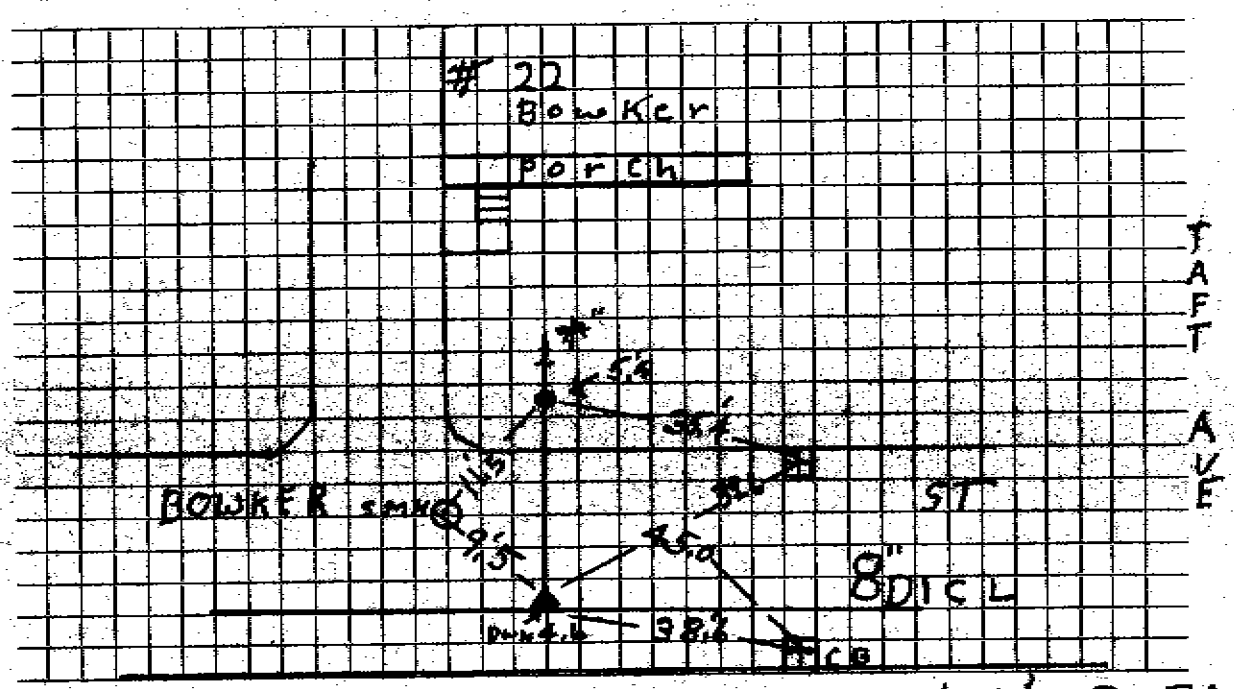

Connection made in ..... Street. Work completed 9/14/09 P.A.O.

Remarks: .....