R.B.M.16010

WATER SERVICE RECORD

Name ~~XXXXXXXXXX~~ Thomas A. Rosse **Service No.**

Address ~~XXXXXXXXXXXXXXXX~~ # 17 Brent Road

Location ~~Lot #30~~ Lot 31

~~XXXXXXXXXXXXXXXX~~ **New Service** Eagle #1296 Lucente #A200

Date		Material	Amount		Total		Date			Amount	
	50'	3/4" Copper tubing									
3-27-69	42'	3/4" Copper tubing									

DATE _____

TOWN OF LEXINGTON — BOARD OF PUBLIC WORKS

WATER DIVISION

Sketch of Service Here

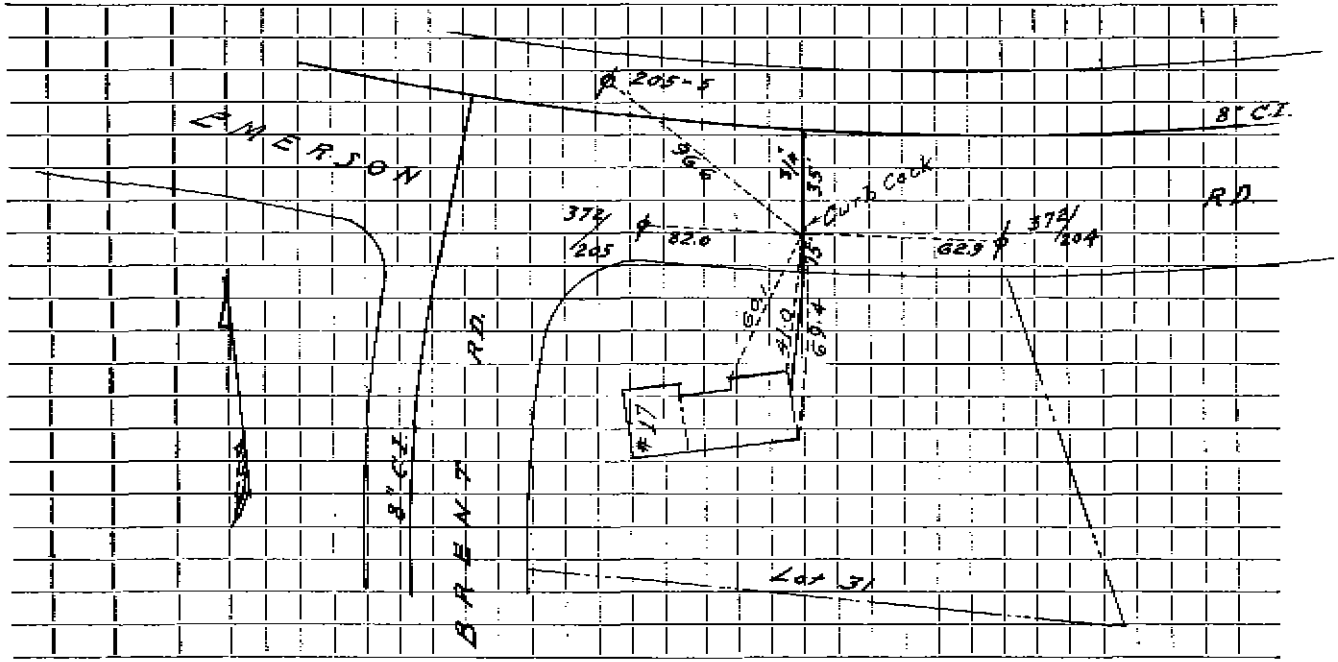

Connection made in ..... Street. Work completed .....

Remarks: .....

.....

.....