F.B.K.16010

WATER SERVICE RECORD

Name J. Castoldi **Service No.**

Address ~~306 Emerson Road~~ 23 Brent Road

Location Lot #29 Changed per Engineering 8/3/77

~~**Repair—Renewal**~~—**New Service** Lucente A198 # 517 -Richard Gately

Date		Material	Amount		Total		Date			Amount	
	50'	3/4" Copper tubing									
1/4/67		63'3/4"copper									

DATE _____

TOWN OF LEXINGTON — BOARD OF PUBLIC WORKS

WATER DIVISION

Sketch of Service Here

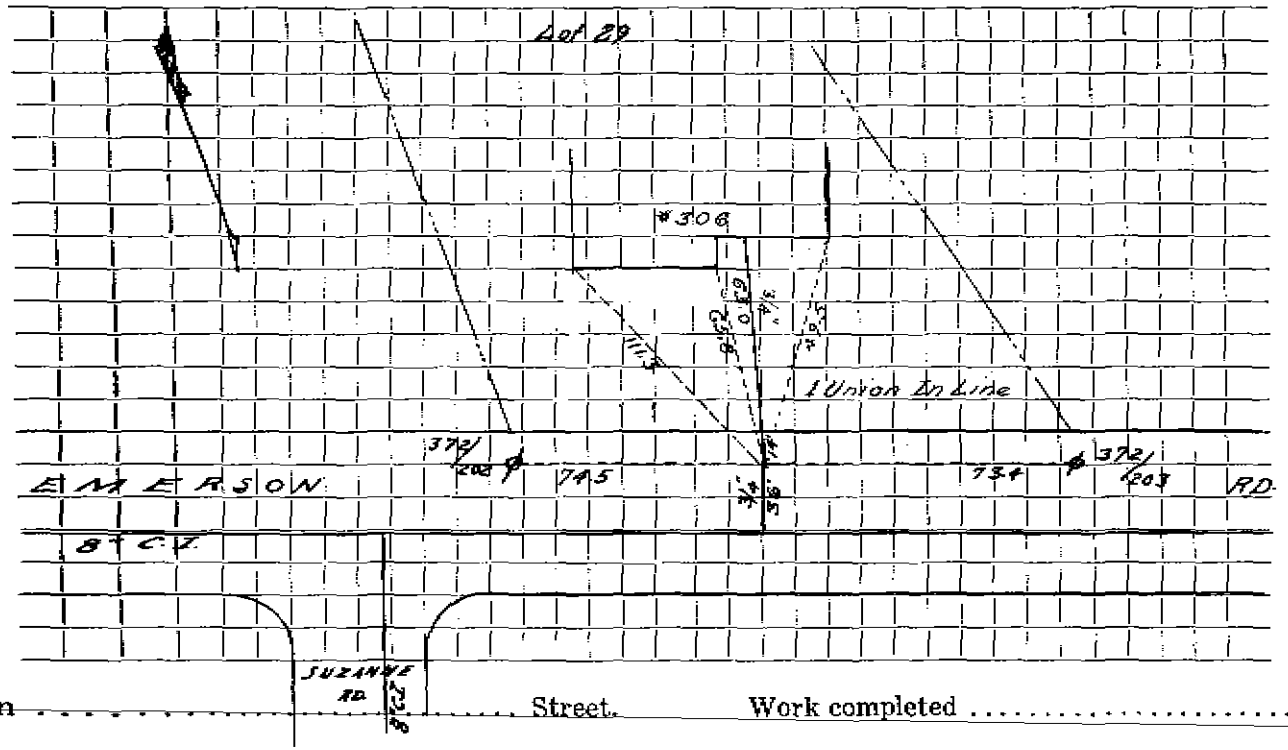

Connection made in ..... Street. Work completed .....

Remarks: .....

.....

.....