WATER SERVICE RECORD

Name *Diamond West Realty Trust* Service No.

Address *66 BRIDGE ST.*

Location

~~Repair~~ ~~Renewal~~ New Service *Redmond 4271*

Date		Material	Amount	Total	Date			Amount
4/15/86	*112'*	*1" Copper*						
					4/15/86	*28'*	*1" Copper*	
						1	*1" Corp.*	
						1	*1" Curb*	
						1	*3part Union*	

DATE _____

TOWN OF LEXINGTON — BOARD OF PUBLIC WORKS

WATER DIVISION

Sketch of Service Here

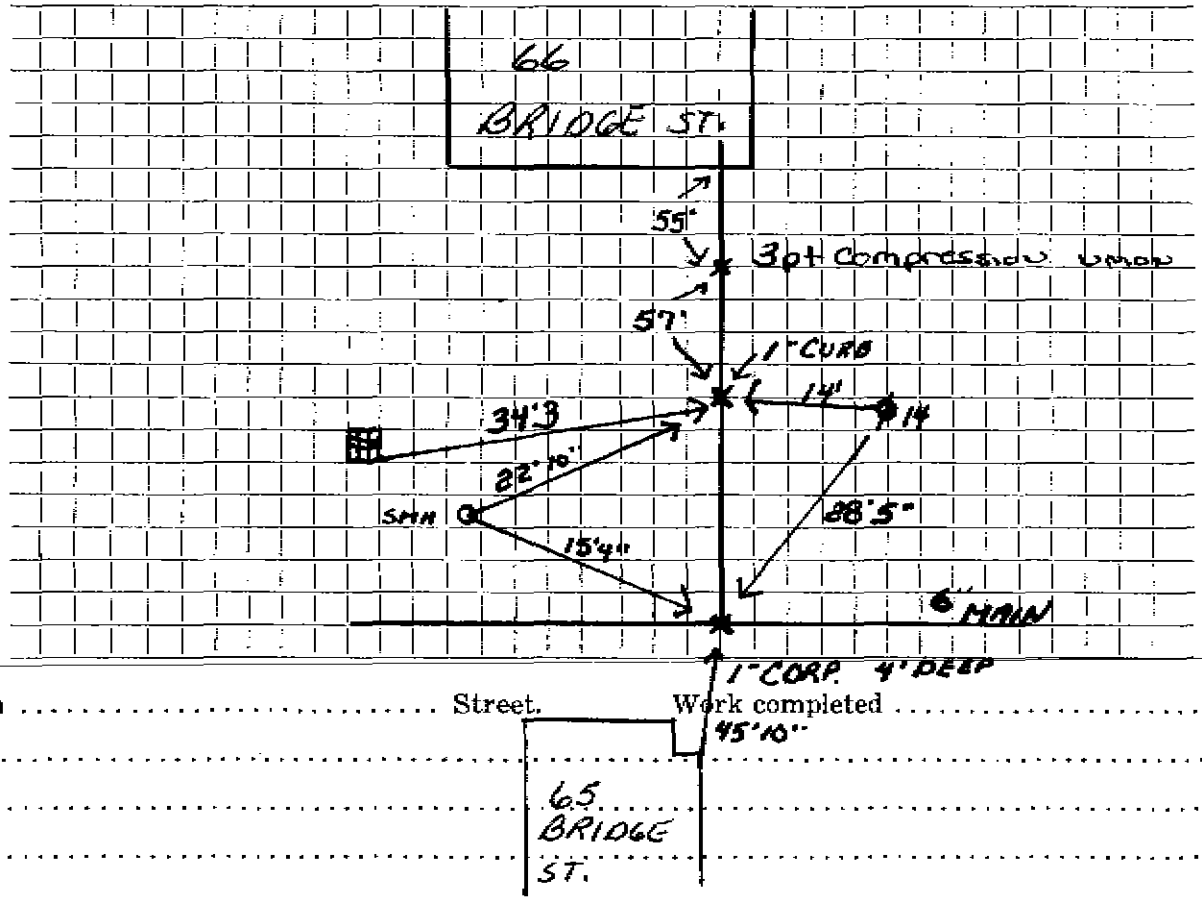

Connection made in ..... Street. Work completed .....

Remarks: .....

.....

.....