E.B.M.16010

WATER SERVICE RECORD

Name Moore Realty Trust **Service No.**

Address 11 Brigham Road

Location Lot #6

~~Repair~~ ~~Renewal~~ **New Service** DeFlice #966 J.M.Lucente Permit #244

Date		Material	Amount		Total		Date			Amount	
4-14-65	58'	3/4" Copper tubing									
3-26-68	50'	3/4" Copper tubing									

DATE _____

TOWN OF LEXINGTON — BOARD OF PUBLIC WORKS

WATER DIVISION

Sketch of Service Here

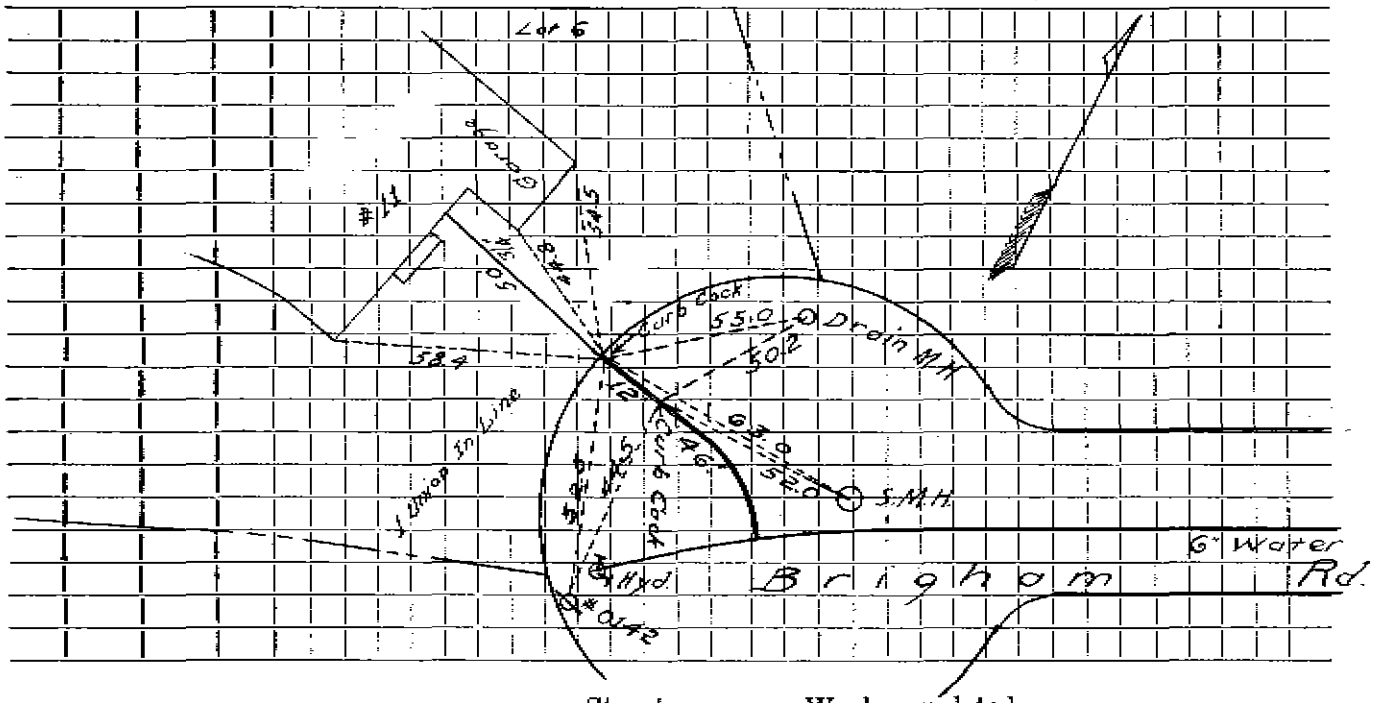

Connection made in ..... Street. Work completed .....

Remarks: .....

.....

.....