R.B.M.1601D

WATER SERVICE RECORD

Name Moore Realty Trust **Service No.**

Address 9 Brigham Road

Location Lot #5

~~Service Renewal~~—**New Service** J.M.Lucente

Date		Material	Amount		Total		Date			Amount	
4-14-65	58'	3/4" Copper tubing									
4/4/67	#5	Copper tubing									

DATE _____

TOWN OF LEXINGTON — BOARD OF PUBLIC WORKS

WATER DIVISION

Sketch of Service Here

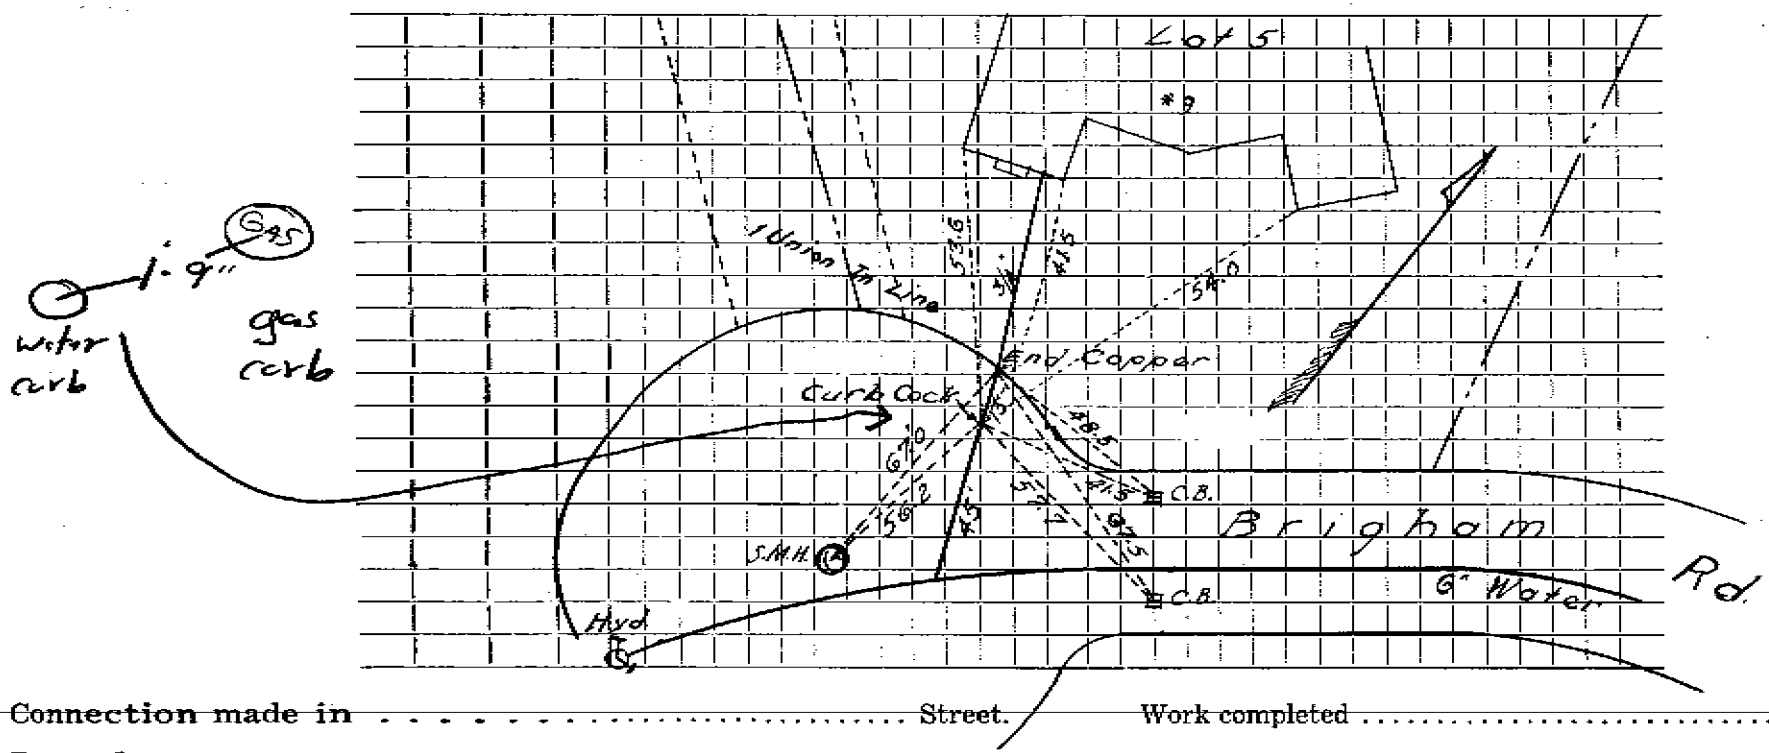

Connection made in . . . . . Street. Work completed . . . . . .

Remarks: . . . . . .

. . . . . .

. . . . . .