H.B.M.16010

WATER SERVICE RECORD

Name Oak Park Corp. **Service No.**

Address 11 Brookwood Rd.

Location

Repair—Renewal—New Service Lucente #1586

Date		Material	Amount	Total	Date		Amount
5-15-70	37'	3/4" Copper tubing					

#11 Brookwood Road

DATE

TOWN OF LEXINGTON — BOARD OF PUBLIC WORKS

WATER DIVISION

Sketch of Service Here

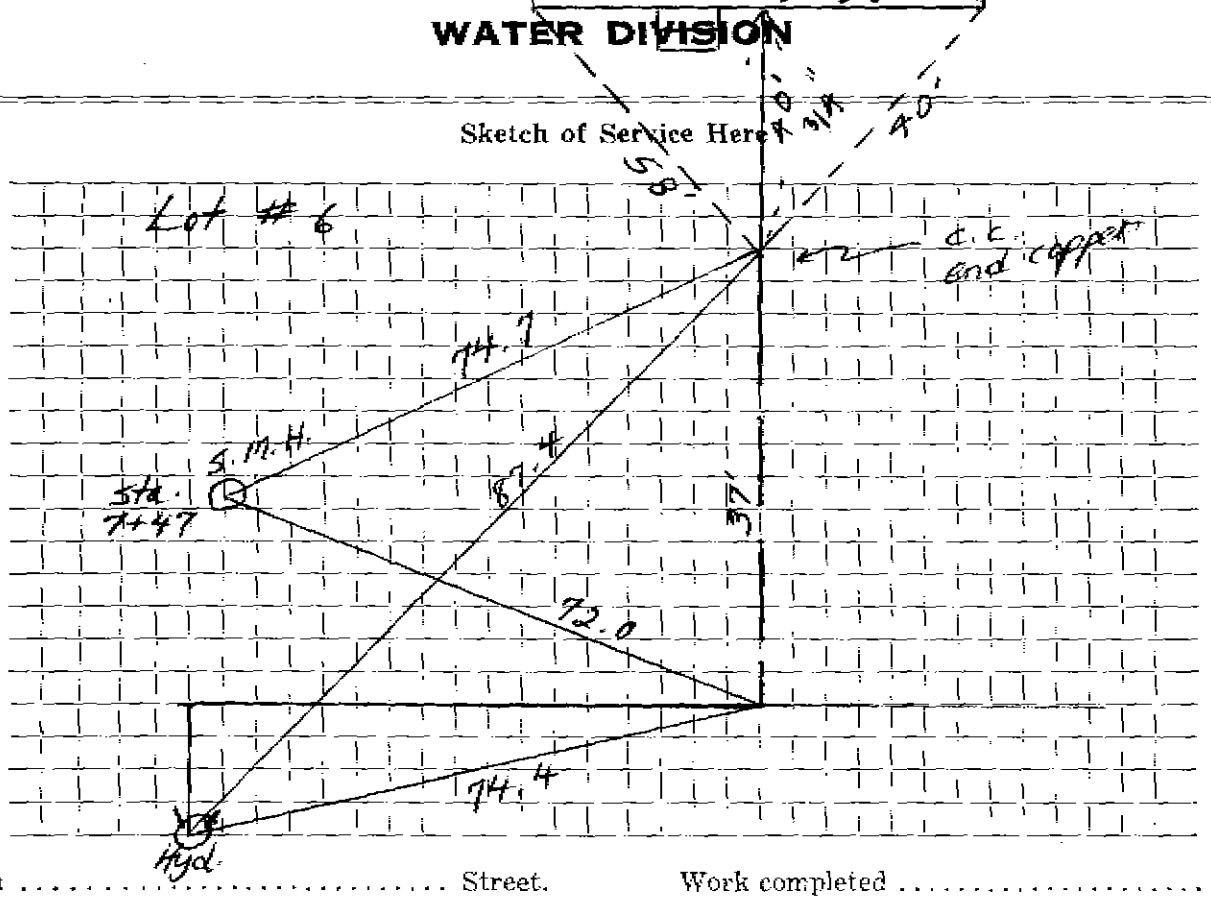

Connection made in ..... Street. Work completed .....

Remarks: .....

.....

.....