WATER SERVICE RECORD

Name **Service No.**

Address 9 Butler Avenue

Location

Repair—Renewal—New Service

Date		Material	Amount	Total	Date			Amount
11/3/94	50'	1" Copper						
		3/4" x 1" Union						
		1" Value						
					11/3/94	17'	3/4" Copper	
						3'	1" Copper	
							1" Corporation	
							1" x 3/4" Union	
							3/4" Curb	
							Box & Rod	

DATE _____

TOWN OF LEXINGTON — BOARD OF PUBLIC WORKS

WATER DIVISION

Sketch of Service Here

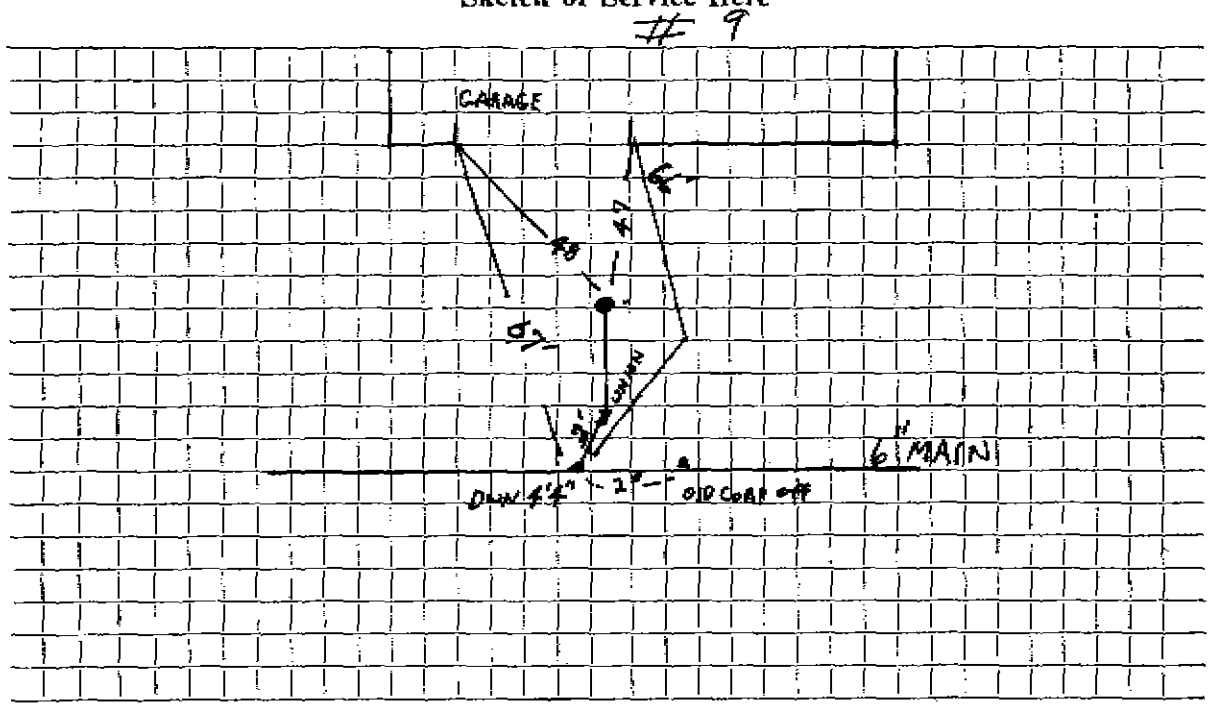

Connection made in BUTLER ..... Street. Work completed .....

Remarks: 1" CORP. FLARE, 3'-1" COPPER, 1" X 3/4" CAP ON .....