H.P.M.16210

WATER SERVICE RECORD

Name **Service No.**

Address 8 Carmel Circle

Location Lot #3

Repair—Renewal—New Service Lucente #1331

Date	Material	Amount	Total	Date		Amount
5-17-69	29' 3/4" Copper tubing					

DATE _____

TOWN OF LEXINGTON — BOARD OF PUBLIC WORKS

WATER DIVISION

Sketch of Service Here

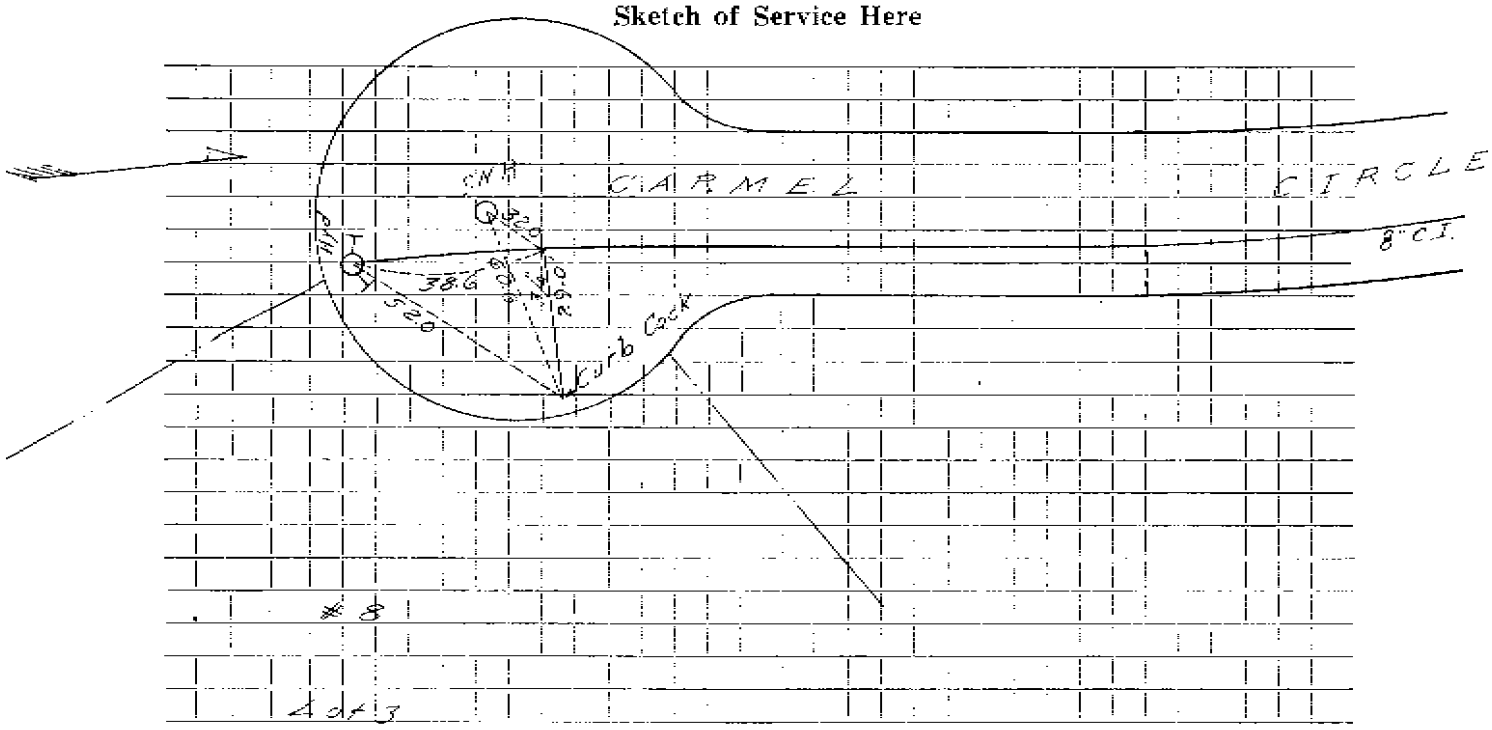

Connection made in ..... Street. Work completed .....

Remarks: .....

.....

.....