S.S.M.15010

5085

WATER SERVICE RECORD

Name Alfred Camarano **Service No.**

Address 19 Carriage Drive

Location Lot #20

~~Repair Renewal~~ **New Service** John Devine Permit #292

Ferrari Plumbing #A345

AUG 9 1965

Date		Material	Amount	Total	Date		Amount
8/3/65	25'	3/4" Copper tubing					
6/21/66	60'	3/4" Copper tubing					

DATE _____

TOWN OF LEXINGTON — BOARD OF PUBLIC WORKS

WATER DIVISION

Sketch of Service Here

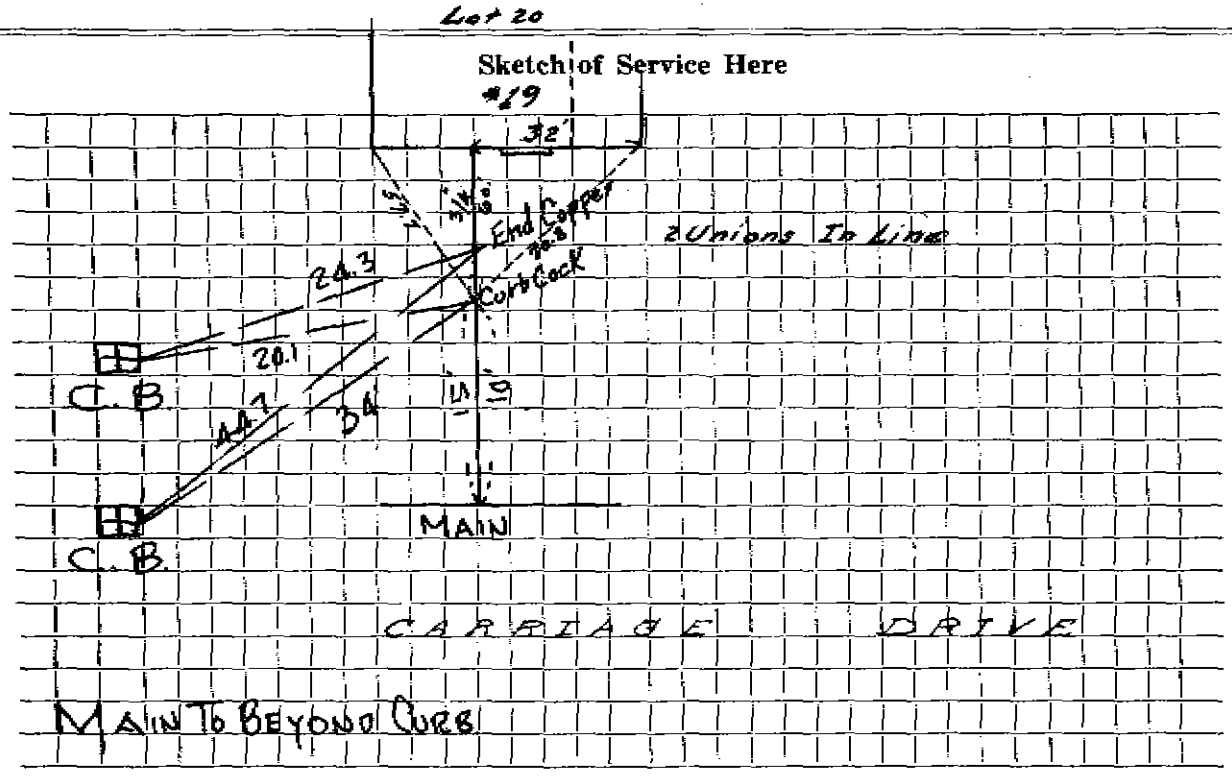

Connection made in ..... Street. Work completed .....

Remarks: .....

.....

.....