WATER SERVICE RECORD

Name Woodhaven Realty **Service No.**

Address 28 CARRIAGE DR. LOT #10

Location

Repair—Renewal—(New Service) James Mc Laughlin 4745

Date		Material	Amount	Total	Date		Amount
6/20	88						
		1" C/C & BOX					
		1" CORP					
9/26	89	1" K COPPER					
		1" 53' K COPPER					

DATE _____

TOWN OF LEXINGTON — BOARD OF PUBLIC WORKS

WATER DIVISION

Sketch of Service Here

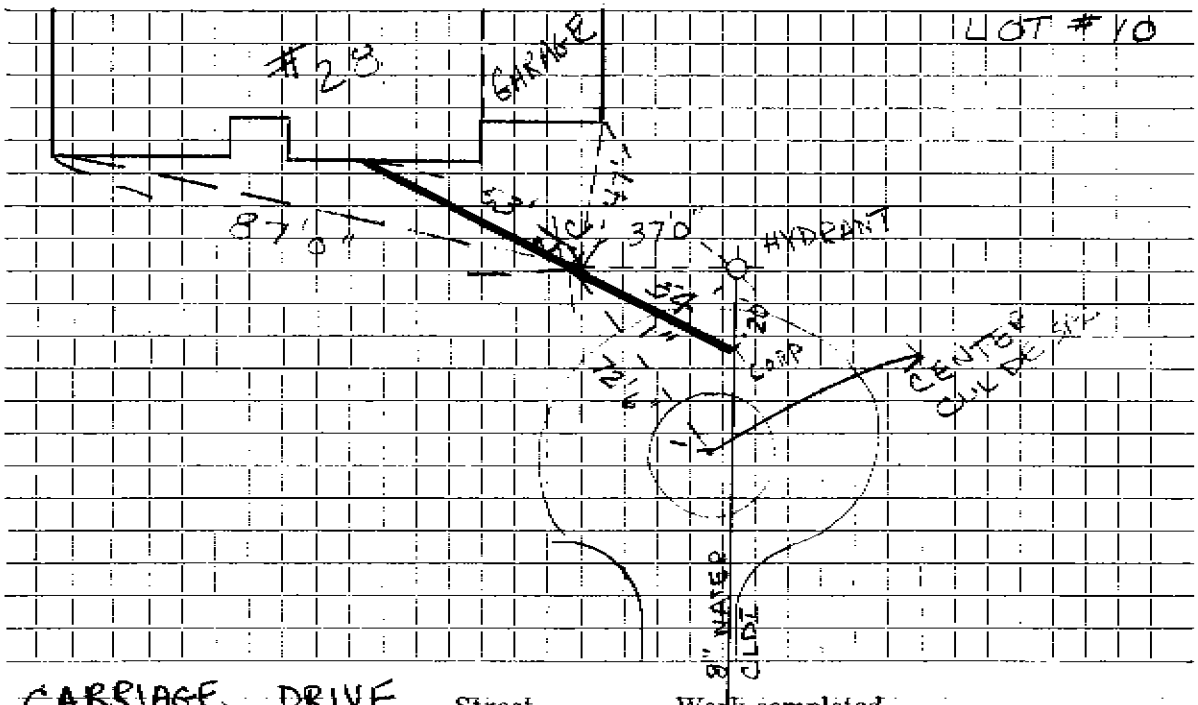

Connection made in CARRIAGE DRIVE Street. Work completed .....

Remarks: .....